

K 160
 Harrison
 1/17/75

MISSISSIPPI
 BOARD OF WATER COMMISSIONERS
 416 North State Street
 Jackson, Mississippi 39201

CODED

WATER WELL DRILLERS LOG

JAN. 17 1975 Ladnier's Well Works HARRISON
 date well completed firm name county well located

LANDOWNER: Jake Bell
 County Farm Road
 Gulfport, MS 39501
 (mailing address)


description of formations encountered	from	to
yellow sand & clay	0	90
blue clay	90	480
blue sand	480	525

WELL LOCATION:
 sec. 3 T. 7 S. R. 12 W.
 1 1/2 miles W of Landon
 (distance) (direction) (nearest town)

WELL PURPOSE: home
 (home, irrigation, municipal, industrial)

- WELL COMPLETION DATA:
- (1) diameter (inches) 2 in.
 - (2) total depth (feet) 525 ft.
 - (3) static water level (feet) 15 below above top of ground.
 - (4) casing Plastic 505.
 (material) (depth)
 2 in. (size) if telescope see back.
 - (5) screen 20 ft. 505
 (length) (depth to top)
 2 in. plastic
 (size) (material)
 - (6) pump 1 (HP) 9 (yield gpm)
 elec.
 (type power)
 - (7) electric log NO
 (yes or no)
 - (organization running log)
 - (8) how well bottom plugged well check

DRILLERS REMARKS:

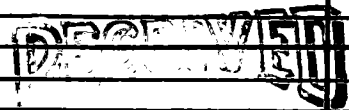

MAY 27 1975

If well telescopes please sketch and show depths.

GROUND LEVEL

			X 9

SECTION 3

Please indicate well location X.

ADDITIONAL INFORMATION

If more than one screen, show locations of each on sketch.