

Harrison
 K 161
 3/11/74

MISSISSIPPI
 BOARD OF WATER COMMISSIONERS
 416 North State Street
 Jackson, Mississippi 39201

CODED

WATER WELL DRILLERS LOG

3/11/74 date well completed
 Pineville Water Work firm name
 Harrison county well located

LANDOWNER: Southern
 Racquet Club, 28th St
 Gulfport Miss
 (mailing address)

description of formations encountered	from	to

WELL LOCATION:
 sec 38 T 2 N R 12 E 135
 7 mi miles West of Gulfport
 (distance) (direction) (nearest town)

floor dirt to	0	30'
pea gravel & sand	30'	60'
white pipe clay	60'	140'
blue pipe clay	140'	420'
Coarse water sand	420'	435'

WELL PURPOSE: Irrigation
 (home, irrigation, municipal, industrial)

had to have more had for well pipe had pipe clay from	435'	560'
Coarse water sand & fine gravel	560'	624'

WELL COMPLETION DATA:

- (1) diameter (inches) 2 1/4
- (2) total depth (feet) 624
- (3) static water level (feet) 2 below top of ground
- (4) casing pipe steel, 604 (material) (depth)
2 1/4 (size) If telescope see back.
- (5) screen 20, 604 (length) (depth to top)
2, all steel (size) (material)
- (6) pump 5 (HP) 65 (yield gpm)
4 hp (type power)
- (7) electric log None (yes or no)

150 ft 4" pipe to 40
 45 ft 2" gal pipe
 20 ft all steel


(organization running log)
 (8) how well bottom plugged 2" sand
 Shank

DRILLERS REMARKS: had to
 fabricate 50 gal pipe
 @ 50455107

DEPT OF WATER
 MAR 19 1975
 MISS. BD. OF WATER

If well telescopes please sketch and show depths.

GROUND LEVEL

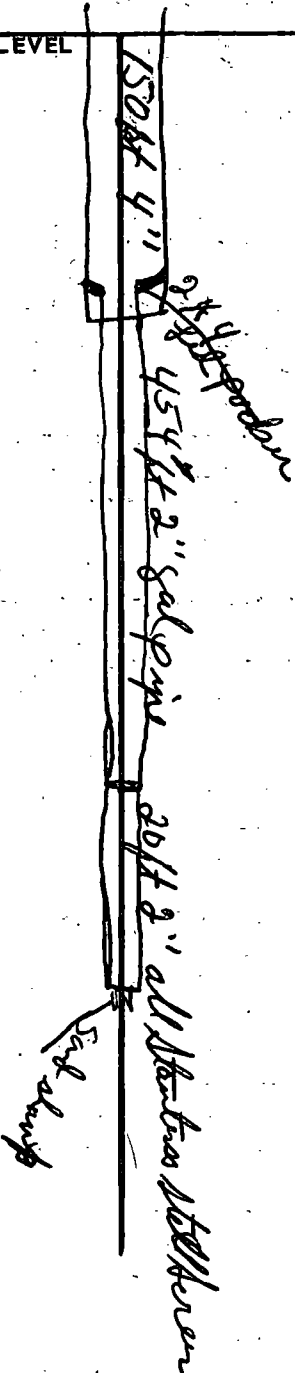

		X	

SECTION 35

Please indicate well location X.

ADDITIONAL INFORMATION

non 55 gal drum
over top of 65 PST
in 4-7 section

If more than one screen, show locations of each on sketch.