

HARRISON
K 166
12-10-76

MISSISSIPPI
 BOARD OF WATER COMMISSIONERS
 416 North State Street
 Jackson, Mississippi 39201 **CODED**

WATER WELL DRILLERS LOG

Dec. 10 19 76 McBride well works Harrison
 date well completed firm name county well located
Inc.

LANDOWNER: McCaie Const. Co.
Gen. Del.
Delisle, Mo.
 (mailing address)
 WELL LOCATION:
 20 sec. 21 T 7 N R. 12 W
10 miles W of Jordan
 (distance) (direction) (nearest town)

WELL PURPOSE:
 (home, irrigation, municipal, industrial)

WELL COMPLETION DATA:
 (1) diameter (inches) 4"
 (2) total depth (feet) 500' 609'
 (3) static water level (feet) 16' below top of ground.
 (4) casing sch. 40 589'
 (material) (depth)
4" If telescope see back.
 (size)
 (5) screen 20' -
 (length) (depth to top)
4" plastic
 (size) (material)
 (6) pump 5H sub. 150
 (HP) (yield gpm)
electric
 (type power)
 (7) electric log no
 (yes or no)
 (organization running log)
 (8) how well bottom plugged land
fresh

| description of formations encountered | from | to |
|---------------------------------------|------|-----|
| mud clay | 0 | 21 |
| sand gravel mixed | 21 | 42 |
| sand | 42 | 63 |
| sand | 63 | 74 |
| mud | 74 | 84 |
| sand | 84 | 105 |
| sand | 105 | 126 |
| sand & mud | 126 | 147 |
| mud | 147 | 168 |
| mud | 168 | 189 |
| mud | 189 | 210 |
| mud | 210 | 231 |
| mud | 231 | 252 |
| sand | 252 | 273 |
| sand | 273 | 294 |
| sand | 294 | 305 |
| mud | 305 | 315 |
| mud | 315 | 320 |
| sand | 320 | 326 |
| mud | 326 | 336 |
| mud | 336 | 353 |
| sand | 353 | 357 |
| sand | 357 | 378 |
| mud | 378 | 399 |
| mud | 399 | 420 |
| mud-sand | 420 | 441 |
| mud | 441 | 462 |
| mud sand | 462 | 483 |
| mud sand | 483 | 504 |
| mud | 504 | 525 |
| mud-sand | 525 | 546 |
| sand | 546 | 567 |
| coarse sand | 567 | 609 |


CODED

RECEIVED
 JUL 11 1977

DRILLERS REMARKS:

If well telescopes please sketch and show depths.

GROUND LEVEL

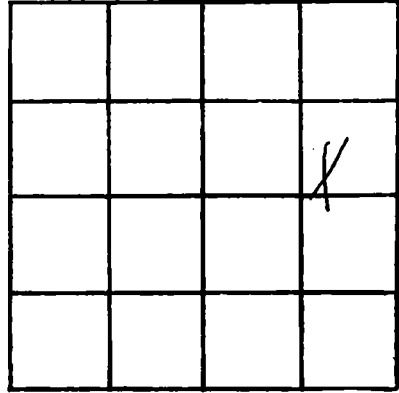

SECTION 21

Please indicate well location X.

ADDITIONAL INFORMATION

If more than one screen, show locations of each on sketch.