

MISSISSIPPI DEPARTMENT OF NATURAL RESOURCES

Bureau of Land and Water Resources

Southport Mall

P.O. Box 10631

Jackson, Mississippi 39209

WATER WELL DRILLERS LOG

CODED

Harrison
K171
2/26/81

2/26/81 19 Lyman Well Co. Harrison
 date well completed firm name county well located

LANDOWNER: H. L. Hammitt
Rt 2 Box 13-B
Pass Christian, Md 39511
 (mailing address)

WELL LOCATION:
 sec. 7 T. 2 N. R. 12 E.
 (distance) miles (direction) of (nearest town)

WELL PURPOSE: home
 (home, irrigation, municipal, industrial)

WELL COMPLETION DATA:

(1) diameter (inches) 2 1/2"

(2) total depth (feet) 430'

(3) static water level (feet) +5 below/above top of ground.

(4) casing PVC 420'
 (material) (depth)

2 1/2" If telescope see back.
 (size)

(5) screen 10' 420'
 (length) (depth to top)

2 1/2" PVC
 (size) (material)

(6) pump 1 20
 (HP) (yield gpm)


electric
 (type power)

(7) electric log No
 (yes or no)

(organization running log)

(8) how well bottom plugged sand
shark


description of formations encountered	from	to
yellow clay	0	8
white sand	8	35-
gray clay & sand	35	110
blue clay	110	385-
SAND	385	430

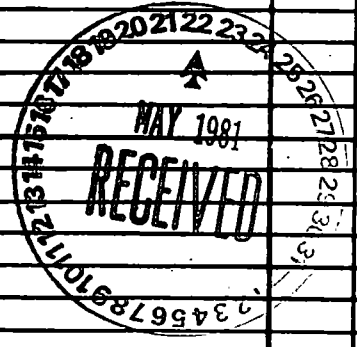

DRILLERS REMARKS: set 40
ft off bottom sand
was fine

If well telescopes please sketch and show depths.

GROUND LEVEL

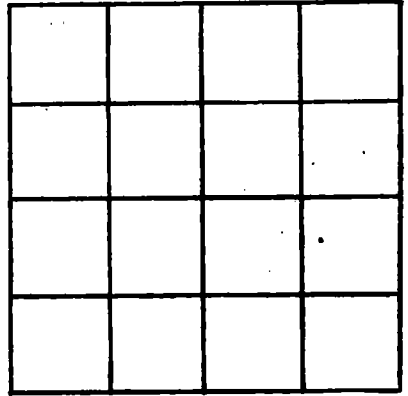

SECTION _____

Please indicate well location X.

ADDITIONAL INFORMATION

If more than one screen, show locations of each on sketch.