

MISSISSIPPI DEPARTMENT OF NATURAL RESOURCES

Bureau of Land and Water Resources

Southport Mall

P.O. Box 10631

Jackson, Mississippi 39209

WATER WELL DRILLERS LOG

HARRISON
K172
10/25/82

10/25
date well completed

82 Lyman Well Co.
firm name

HARRISON
county well located

LANDOWNER: Robert Hayes
Hayes Rd.
Long Beach, Md
(mailing address)

description of formations encountered

from

to

Gravel Sand 0 50
Clay 50 160
Sand 160 205

WELL LOCATION:

sec 27 T 7 N R 12 E
3 miles N of Long Beach
(distance) (direction) (nearest town)

WELL PURPOSE: irrigation
(home, irrigation, municipal, industrial)

WELL COMPLETION DATA:

- (1) diameter (inches) 4"
- (2) total depth (feet) 205'
- (3) static water level (feet) 19 Below top of ground
- (4) casing PVC 295' (material), (depth)
4" (size) if telescope see back.
- (5) screen 10' 205' (length), (depth to top)
4" (size), PVC (material)
- (6) pump 2 (HP) 50 (yield gpm)
Elect (type power)
- (7) electric log NO (yes or no)
NO (organization running log)

CODED

(8) how well bottom plugged Sand
plug

DRILLERS REMARKS:


DEPT. OF NATURAL RESOURCES
BUREAU OF LAND & WATER RESOURCES

FEB 26 1983

RECEIVED

If well telescopes please sketch and show depths.

GROUND LEVEL

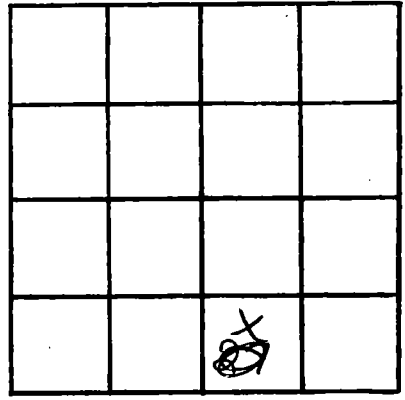

SECTION 27

Please indicate well location X.

ADDITIONAL INFORMATION

A series of horizontal lines for entering additional information.

If more than one screen, show locations of each on sketch.