

MISSISSIPPI DEPARTMENT OF NATURAL RESOURCES

Bureau of Land and Water Resources

Southport Mall

P.O. Box 10631

Jackson, Mississippi 39209

WATER WELL DRILLERS LOG

**CODED**

K 173  
Harrison  
10-7-83

10/7 1983 Braden Pump Well Harrison  
date well completed firm name county well located

LANDOWNER: Harold Kregar  
Rt. 1, Box 409  
Southport, Ms. 39523  
(mailing address)

description of formations encountered	from	to
Clay	0	20
white clay	20	40
blue clay	40	60
sand. Brown	60	100
blue clay	100	200
sand grey	200	240

WELL LOCATION:  
sec. 11 T. 7 S. R. 12 E  
8 miles N of Long Beach  
(distance) (direction) (nearest town)

WELL PURPOSE: Home  
(home, irrigation, municipal, industrial)

- WELL COMPLETION DATA:
- (1) diameter (inches) 4"
  - (2) total depth (feet) 240
  - (3) static water level (feet) 20 below top of ground.
  - (4) casing PVC 225217'  
(material) (depth)
  - 4" if telescope see back.  
(size)
  - (5) screen 18' 217'  
(length) (depth to top)
  - 4" PVC  
(size) (material)
  - (6) pump 3 50  
(HP) (yield gpm)
  - 230V  
(type power)
  - (7) electric log no  
(yes or no)
  - (organization running log)
  - (8) how well bottom plugged 2" PVC  
Sandstone

DRILLERS REMARKS: 5' tail pipe


DEPT. OF NATURAL RESOURCES  
BUREAU OF LAND & WATER RESOURCES

OCT 17 1983

**RECEIVED**

If well telescopes please sketch and show depths.

GROUND LEVEL

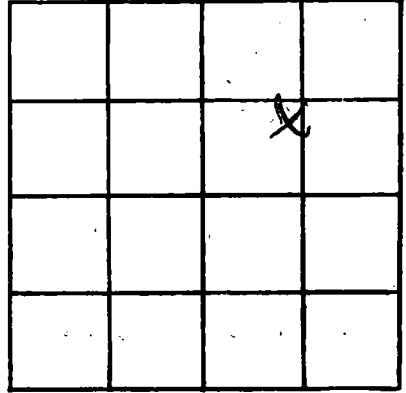

SECTION 11

Please indicate well location X.

ADDITIONAL INFORMATION

If more than one screen, show locations of each on sketch.