

Harrison
 K 179
 7-16-75

MISSISSIPPI
 BOARD OF WATER COMMISSIONERS
 416 North State Street
 Jackson, Mississippi 39201

CODED

WATER WELL DRILLERS LOG

July 16 1975 Mc Mill Well Works Harrison
 date well completed firm name county well located

LANDOWNER: W.M. Stafford
County farm road,
Shufflet, Miss
 (mailing address)

WELL LOCATION:
 sec. 21 T. 7 N R. 12 E ¹³⁵
8 miles SW of London
 (distance) (direction) (nearest town)

WELL PURPOSE: Home
 (home, irrigation, municipal, industrial)

WELL COMPLETION DATA:
 (1) diameter (inches) 2"
 (2) total depth (feet) 500'
 (3) static water level (feet) 90 ^{below} _{above} top of ground.
 (4) casing plastic 490
 (material) (depth)
 (size) If telescope see back.
 (5) screen 10'
 (length) (depth to top)
2" 3.5
 (size) (material)
 (6) pump 1 6
 (HP) (yield gpm)
electric
 (type power)
 (7) electric log no
 (yes or no)
 (organization running log)
 (8) how well bottom plugged sand
shark

description of formations encountered	from	to
clay	0	49
Red sand	49	91
Blue clay	91	167
slush	167	210
blue sand	210	239
Blue clay	239	291
blue sand	291	336
Blue clay	336	372
slush	372	419
Blue clay	419	478
coarse sand	478	500

CODED


DECEMBER

NOV 28 1975

DRILLERS REMARKS:

If well telescopes please sketch and show depths.

GROUND LEVEL

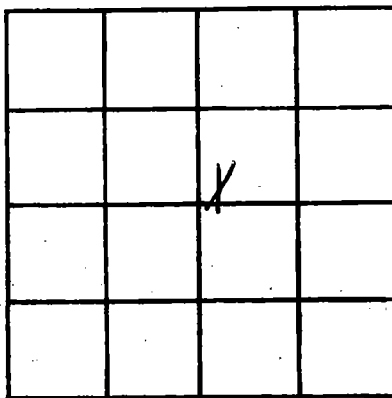

SECTION 21

Please indicate well location X.

ADDITIONAL INFORMATION

If more than one screen, show locations of each on sketch.