

Harrison  
K 181  
12-8-75

MISSISSIPPI  
 BOARD OF WATER COMMISSIONERS  
 416 North State Street  
 Jackson, Mississippi 39201

**CODED**

WATER WELL DRILLERS LOG

8 DEC 1975 BRYANT WELL CO HARRISON  
 date well completed firm name county well located

LANDOWNER: WOODFIELD FARMS  
530 BEACH BLVD  
GULFSPOAT, MS.  
 (mailing address)

description of formations encountered	from	to
RED CLAY	0	11
SAND & FINE GRAVEL	11	34
RED CLAY	34	97
FINE SAND	97	149
BLUE CLAY	149	172
GOOD SAND	172	236


WELL LOCATION:  
 sec. 9 T. 7 S. R. 12 W.  
7 miles NW of Gulfport  
 (distance) (direction) (nearest town)

WELL PURPOSE: HOME  
 (home, irrigation, municipal, industrial)

- WELL COMPLETION DATA:
- (1) diameter (inches) 2
  - (2) total depth (feet) 236
  - (3) static water level (feet) 27 below top of ground.
  - (4) casing PVC, 231  
 (material) (depth)  
 (size) if telescope see back.
  - (5) screen 5', 231  
 (length) (depth to top)  
200, PVC  
 (size) (material)
  - (6) pump 1 10  
 (HP) (yield gpm)  
Electric  
 (type power)
  - (7) electric log \_\_\_\_\_  
 (yes or no)

**CODED**

(organization running log)  
 (8) how well bottom plugged METAL SAND SHANK

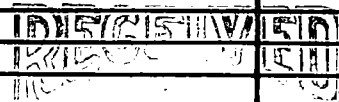

DEC 17 1975

DRILLERS REMARKS:

If well telescopes please sketch and show depths.

GROUND LEVEL

		K	

SECTION 9

Please indicate well location X.

ADDITIONAL INFORMATION

If more than one screen,  
show locations of each on sketch.