

HARRISON
K 182
2/28/76

MISSISSIPPI
BOARD OF WATER COMMISSIONERS
416 North State Street
Jackson, Mississippi 39201

CODED

WATER WELL DRILLERS LOG
COASTAL DRILLING & SERVICE CO.

2/28/76 19 date well completed
ROUTE 1 BOX 618 farm name
Harrison county well located
BILOXI, MISS. 39532

LANDOWNER: Harrison City
Beat Three Cam
Long Beach, Miss
(mailing address)

WELL LOCATION:
sec 34 T 2 N R 12 E
S W
Long Beach, Miss
(distance) (direction) (nearest town)

WELL PURPOSE: City Cam
(home, irrigation, municipal, industrial)

WELL COMPLETION DATA:
(1) diameter (inches) 4 1/2"
(2) total depth (feet) 510'
(3) static water level (feet) 7 below top of ground.
(4) casing 4 1/2" (material) 495' (depth)
4 1/2" (size) If telescope see back.
(5) screen 15' (length) 495' (depth to top)
2" (size) SS (material)
(6) pump 1/2 (HP) 30 (yield gpm)
Ele (type power)
(7) electric log no (yes or no)
(organization running log)

(8) how well bottom plugged
S 1/2 inch steel

DRILLERS REMARKS:
None


description of formations encountered	from	to
Top Soil	1	3
Red Sand	3	15
Red Clay	15	30
White Sand	30	25
Soft blue clay	25	210
fine white sand	210	230
Soft blue clay	230	300
fine white sand	300	330
hard blue clay	330	450
fine white sand	450	470
Permeable sand	470	570

CODED

MAR 31 1976
MISS. BO OF WATER COM

If well telescopes please sketch and show depths.

GROUND LEVEL

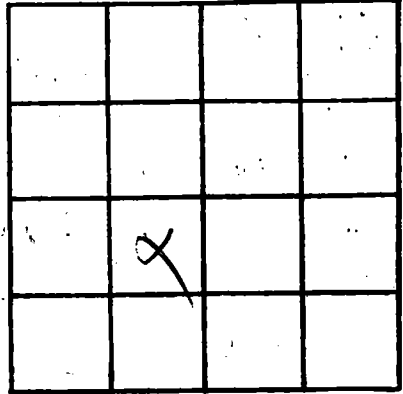

SECTION _____

Please indicate well location X.

ADDITIONAL INFORMATION

If more than one screen, show locations of each on sketch.