

**HARRISON**  
**K 183**  
**2-28-76**

MISSISSIPPI  
 BOARD OF WATER COMMISSIONERS  
 416 North State Street  
 Jackson, Mississippi 39201

**CODED**

**WATER WELL DRILLERS LOG**

28 FEB 1976 BAYANT Well Co HARRISON  
 date well completed firm name county well located

LANDOWNER: KEVIN MEYER  
RT 1 Box 507  
Long Beach, Ms.  
 (mailing address)

description of formations encountered	depth	
	from	to
CLAY	0	20
SAND	20	31
BLUE CLAY	31	136
GOOD SAND	136	183

WELL LOCATION:  
 sec. 33 T 7 S R 12 W  
3 miles NW of Long Beach  
 (distance) (direction) (nearest town)

WELL PURPOSE:  
 (Home, Irrigation, municipal, Industrial)

**CODED**

WELL COMPLETION DATA:

(1) diameter (inches) 2

(2) total depth (feet) 183'

(3) static water level (feet) 17 below above top of ground.

(4) casing PVC, 179,  
 (material) (depth)  
 (size) If telescope see back.


(5) screen 5', 179  
 (length) (depth to top)  
2", PVC  
 (size) (material)

(6) pump 1 (HP) 12 (yield gpm)  
ELECT  
 (type power)

(7) electric log NO  
 (yes or no)

(organization running log)

(8) how well bottom plugged Metal sand  
SHANK

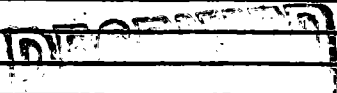

MAY - 5 1976

DRILLERS REMARKS:

MISS. BD. OF WATER COMMISSIONERS

If well telescopes please sketch and show depths.

GROUND LEVEL

	X		

SECTION 33

Please indicate well location X.

ADDITIONAL INFORMATION

If more than one screen, show locations of each on sketch.