

**HARRISON**  
**K 184**  
**4-13-76**

MISSISSIPPI  
 BOARD OF WATER COMMISSIONERS  
 416 North State Street  
 Jackson, Mississippi 39201

**CODED**

**WATER WELL DRILLERS LOG**

13 April 1976 Bayent Well Co HARRISON  
 date well completed firm name county well located

LANDOWNER: Cliff Suddeth  
PO Box 6435  
Gadsport, Ms. 39501  
 (mailing address)


WELL LOCATION:  
 sec 24 T 7 R 10 S W  
4 miles NW of Long Branch  
 (distance) (direction) (nearest town)

WELL PURPOSE:  
 (home, irrigation, municipal, industrial)

WELL COMPLETION DATA:  
 (1) diameter (inches) 4" x 9"  
 (2) total depth (feet) 621'  
 (3) static water level (feet) 12 below top of ground.  
 (4) casing PVC 611' (material) (depth)  
4" x 9" if telescope see back. (size)  
 (5) screen 10 611' (length) (depth to top)  
20g PVC (size) (material)  
 (6) pump 1 21 (HP) (yield gpm)  
ELECT (type power)  
 (7) electric log NO (yes or no)

description of formations encountered	from	to
CLAY	0	10
COARSE SAND & GRAVEL	10	70
BLUE CLAY	70	109
FINE SAND	109	132
BLUE CLAY	132	175
FINE SAND	175	192
BLUE CLAY	192	200
FINE SAND	200	259
BLUE CLAY	259	467
SAND	467	470
BLUE CLAY	472	498
SAND	498	492
BLUE CLAY	492	552
GOOD SAND	552	621

**CODED**

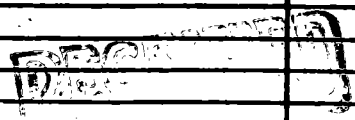

MAY - 3 1976

(organization running log)  
 (8) how well bottom plugged METAL SAND SPARK

DRILLERS REMARKS:

MISS. BD. OF WATER COMM.

If well telescopes please sketch and show depths.

GROUND LEVEL

4" sch 40  
PVC

4x2" REDUCER — 80'

2" sch 40  
PVC

— 611'

10' of 2" PVC  
WRAPPED WELL  
SCREEN

SAND SHANK — 621'

			X
			/

SECTION 28

Please indicate well location X.

ADDITIONAL INFORMATION

If more than one screen,  
show locations of each on sketch.