

HARRISON
 K 186
 6/1/76

MISSISSIPPI
 BOARD OF WATER COMMISSIONERS
 416 North State Street
 Jackson, Mississippi 39201

CODED

WATER WELL DRILLERS LOG
 COASTAL DRILLING & SERVICE CO.

ROUTE 1 BOX 618

Harrison
 county well located

6/1/76
 date well completed

LANDOWNER: Bill Jarell

BILCOI, MISS 39532

description of formations encountered

from to

Rt 3 Box 164
 Ypt, Miss
 (mailing address)

Top Soil	1	3
Red clay	3	20
Red clay	20	33
Red clay	33	45
Soft blue clay	45	67
Blue clay	67	80
Soft blue clay	80	130
Hard blue clay	130	240
fine water sand	240	260
Coarse water sand	260	292

WELL LOCATION:

sec 27 T 2 N R 12 E
 S W
 (4.7) miles NW of Jarell
 (distance) (direction) (nearest town)

WELL PURPOSE: home
 (home, irrigation, municipal, industrial)

CODED

WELL COMPLETION DATA:

- (1) diameter (inches) 2"
- (2) total depth (feet) 292'
- (3) static water level (feet) 15 below above top of ground
- (4) casing PVC 292'
 (material) (depth)
- (size) if telescope see back.
- (5) screen 10' 292'
 (length) (depth to top)
- 2" PVC
 (size) (material)
- (6) pump One 1.5
 (HP) (yield gpm)
- Electric
 (type power)
- (7) electric log No
 (yes or no)

(organization running log)

(8) how well bottom plugged
Backwash valve

DRILLERS REMARKS:


Log by Bill Jarell

RECEIVED
 JUN 29 1976

MISS. Bd. OF WATER

If well telescopes please sketch and show depths.

GROUND LEVEL

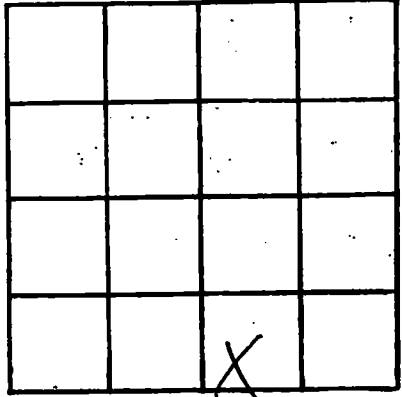

SECTION _____

Please indicate well location X.

ADDITIONAL INFORMATION

A series of horizontal lines for recording additional information.

If more than one screen, show locations of each on sketch.