

6-26-76  
 K 187  
 HARRISON

MISSISSIPPI  
 BOARD OF WATER COMMISSIONERS  
 416 North State Street  
 Jackson, Mississippi 39201

CODED

WATER WELL DRILLERS LOG  
 COASTAL DRILLING & SERVICE CO.

10/26 1972 date well completed  
 ROUTE 1 BOX 618 firm name  
 BILOXI, MISS 39532  
 Harrison county well located

LANDOWNER: Bill Kasky  
 Rt 2 Box 618  
 Apt 1, Miss  
 (mailing address)

description of formations encountered	from	to
Top soil	3	3
White Sand	5	20
Soft Blue Clay	20	180
Fin. water sand	180	210
Coarse water sand	210	225

WELL LOCATION:  
 sec. 7 T. 7 N. R. 2 E.  
 S W  
 Orange Grove  
 (distance) (direction) (nearest town)

CODED

WELL PURPOSE: Home  
 (home, irrigation, municipal, industrial)


WELL COMPLETION DATA:  
 (1) diameter (inches) 2'  
 (2) total depth (feet) 225'  
 (3) static water level (feet) 23 below top of ground.  
 (4) casing PVC, 2 1/2" (material) (depth)  
 (size) If telescope see back.  
 (5) screen 10' 2 1/2" (length) (depth to top)  
 2" PVC (size) (material)  
 (6) pump One 1 1/2 (HP) (yield gpm)  
 Ele (type power)  
 (7) electric log 20 (yes or no)  
 (organization running log)

(8) how well bottom plugged  
 2" sand pack filter

DRILLERS REMARKS:  
 None

If well telescopes please sketch and show depths.

GROUND LEVEL

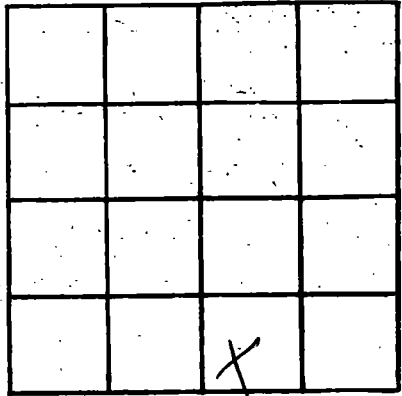

SECTION \_\_\_\_\_

Please indicate well location X.

**ADDITIONAL INFORMATION**

A series of horizontal lines for recording additional information.

If more than one screen, show locations of each on sketch.