

HARRISON
K 188
11-4-76

MISSISSIPPI
BOARD OF WATER COMMISSIONERS
416 North State Street
Jackson, Mississippi 39201

CODED

WATER WELL DRILLERS LOG
COASTAL DRILLING & SERVICE CO.

Harrison

11/4 1976 date well completed
ROUTE 1 BOX 648 county well located

| LANDOWNER | DESCRIPTION OF FORMATIONS ENCOUNTERED | FROM | TO |
|--------------------------|---------------------------------------|------------|------------|
| <i>James R. ...</i> | <i>Top Soil</i> | <i>1</i> | <i>5</i> |
| <i>Rt 1 Box 460</i> | <i>Red Clay</i> | <i>5</i> | <i>15</i> |
| <i>apt. Min 39501</i> | <i>White Sand</i> | <i>15</i> | <i>30</i> |
| <i>(mailing address)</i> | <i>Shells</i> | <i>30</i> | <i>35</i> |
| | <i>Soft Blue Clay</i> | <i>35</i> | <i>70</i> |
| | <i>White Sand</i> | <i>70</i> | <i>100</i> |
| | <i>Soft Blue Clay</i> | <i>100</i> | <i>140</i> |
| | <i>Hard Blue Clay</i> | <i>140</i> | <i>245</i> |
| | <i>Light White Sand</i> | <i>245</i> | <i>270</i> |
| | <i>Coarse White Sand</i> | <i>270</i> | <i>290</i> |

WELL LOCATION:
sec. 16 T 2 N R 12 E
S W
4 1/2 miles N Jones Beach
(distance) (direction) (nearest town)

WELL PURPOSE: Home
(home, irrigation, municipal, industrial)

- WELL COMPLETION DATA:
- (1) diameter (inches) 2"
 - (2) total depth (feet) 290'
 - (3) static water level (feet) 20 below above top of ground.
 - (4) casing PVC 280'
(material) (depth)
 - (size) If telescope see back.
 - (5) screen 10' 280'
(length) (depth to top)
 - 2" PVC
(size) (material)
 - (6) pump One 15
(HP) (yield gpm)
 - Ele
(type power)
 - (7) electric log no
(yes or no)
 - (organization running log)


(8) how well bottom plugged 2"
bottom plugged
DRILLERS REMARKS:

RECEIVED
FEB - 2 1977

MISS. BD. OF WATER COMM

If well telescopes please sketch and show depths.

GROUND LEVEL

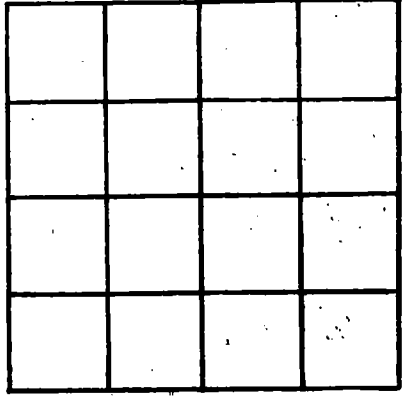

SECTION _____

Please indicate well location X.

ADDITIONAL INFORMATION

Lined area for providing additional information.

If more than one screen, show locations of each on sketch.