

HARRISON  
K 191  
2/28/77

MISSISSIPPI  
BOARD OF WATER COMMISSIONERS  
416 North State Street  
Jackson, Mississippi 39201

CODED

WATER WELL DRILLERS LOG  
COASTAL DRILLING & SERVICE CO.

2/28/77 19 ROUTE 1 BOX 618 Harrison  
date well completed firm name county well located  
BILOXI, MISS 39532

LANDOWNER  
Randy Thomas Beach  
Rt 1 Box 612  
Jorg Beach Min  
(mailing address)

description of formations encountered	from	to
Top Soil		1.5
Red Sand Soil	1.5	1.5
White Sand	1.5	6.5
Soft Blue Clay	6.5	20.0
fine water sand	20.0	22.5
Soft Blue Clay	22.5	28.0
fine water sand	28.0	30.0
hard blue clay	30.0	50.0
fine water sand	50.0	52.0
very coarse water sand	52.0	65

WELL LOCATION:

sec. 16 T 7 N R 12 E  
S W  
3 1/2 miles NW Jorg Beach  
(distance) (direction) (nearest town)

WELL PURPOSE:

home  
(home, irrigation, municipal, industrial)

WELL COMPLETION DATA:

CODED

- (1) diameter (inches) 2"
- (2) total depth (feet) 56.5'
- (3) static water level (feet) 3 below above top of ground
- (4) casing PVC, 55.5' (material) (depth)
- (size) If telescope see back.
- (5) screen 10' length, 55.5' depth to top
- 2" (size) PVC (material)
- (6) pump 1/2 HP, 17 (HP) (yield gpm)
- CLC (type power)
- (7) electric log no (yes or no)

(organization running log)

(8) how well bottom plugged 201  
Robert J. Thomas


DRILLERS REMARKS:

RECEIVED  
APR 4 1977

MISS. BD. OF WATER COMMISSIONERS

If well telescopes please sketch and show depths.

GROUND LEVEL

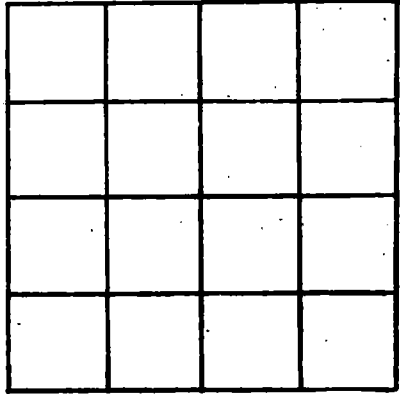

SECTION \_\_\_\_\_

Please indicate well location X.

ADDITIONAL INFORMATION

If more than one screen, show locations of each on sketch.