

HARRISON
K 194
4-15-77

MISSISSIPPI
BOARD OF WATER COMMISSIONERS
416 North State Street
135 Jackson, Mississippi 39201

CODED

WATER WELL DRILLERS LOG

4/15/77 19 Coastal Drilling Harrison
date well completed firm name county well located

LANDOWNER: H.E. Headley
Rt 3
Sulphur, Miss
(mailing address)

description of formations encountered	from	to
Top Soil	1	3
Sandier Clay	3	18
Red Clay	18	40
Soft Blue Clay	40	290
Hard Water Sand	290	340
Hard Blue Clay	340	500
Hard Water Sand	500	520
Coarse Water Sand	520	565

WELL LOCATION:
sec. 7 T 7 N R 12 E
S W
7 1/2 miles N Long Beach
(distance) (direction) (nearest town)

WELL PURPOSE: Home
(home, irrigation, municipal, industrial)

CODED

WELL COMPLETION DATA:

(1) diameter (inches) 2"

(2) total depth (feet) 565'

(3) static water level (feet) 80 below top of ground.

(4) casing PVC, 555'
(material) (depth)
(size) if telescope see back.

(5) screen 10', 555'
(length) (depth to top)
2" PVC
(size) (material)

(6) pump One 10
(HP) (yield gpm)
1/2
(type power)

(7) electric log no
(yes or no)

(organization running log)

(8) how well bottom plugged
2" hard Wash Water


DRILLERS REMARKS:
me

RECEIVED
JUN 28 1977

MISS. BD. OF WATER COMM

If well telescopes please sketch and show depths.

GROUND LEVEL

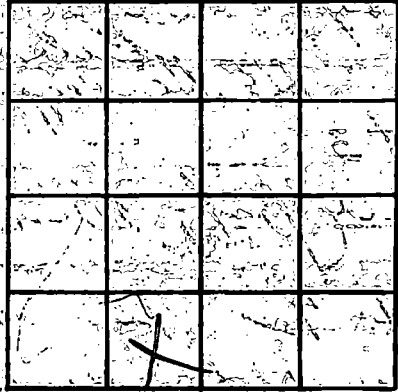

SECTION _____

Please indicate well location X.

ADDITIONAL INFORMATION

If more than one screen, show locations of each on sketch.