

Harrison  
 K 195  
 4/15/77

MISSISSIPPI  
 BOARD OF WATER COMMISSIONERS  
 416 North State Street  
 Jackson, Mississippi 39201

CODED

WATER WELL DRILLERS LOG

4/15/77 Coastal Valley Harrison  
 date well completed firm name county well located

LANDOWNER: H.E. Borham  
 Rt 2 Box 347  
 Gulfport Miss  
 (mailing address)

description of formations encountered	from	to
top soil	1	3
Red Clay	3	15
white sand	15	35
Red Clay	35	55
Soft Blue Clay	55	210
hard Blue Clay	210	270
fine water sand	270	300
hard blue clay	300	370
fine water sand	370	570
very hard blue clay	570	680
fine water sand	680	710
Coarse water sand	710	740

WELL LOCATION:  
 sec. 7 T 7 N R 12 W  
 S W  
 (2.5 miles) N of Long Beach (direction) (nearest town)

WELL PURPOSE: farm  
 (home, irrigation, municipal, industrial)

- WELL COMPLETION DATA:
- (1) diameter (inches) 2"
  - (2) total depth (feet) 740'
  - (3) static water level (feet) 80 below top of ground
  - (4) casing PVC 730' (material) (depth)  
 (size) if telescope see back.
  - (5) screen 10 730' (length) (depth to top)  
 2" PVC (size) (material)
  - (6) pump 1 1/2 10 (HP) (yield gpm)  
 4hp (type power)
  - (7) electric log no (yes or no)
- (organization running log)


(8) how well bottom plugged  
 2' backwash  
 DRILLERS REMARKS: value

JUN 28 1977

MISS. BD. OF WATER COMM.

If well telescopes please sketch and show depths.

GROUND LEVEL

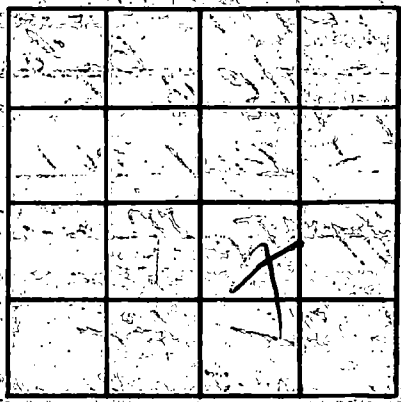

SECTION \_\_\_\_\_

Please indicate well location X.

ADDITIONAL INFORMATION

Multiple horizontal lines for writing additional information.

If more than one screen, show locations of each on sketch.