

HARRISON
K203
10/15/77

MISSISSIPPI
 BOARD OF WATER COMMISSIONERS
 416 North State Street
 Jackson, Mississippi 39201

CODED

WATER WELL DRILLERS LOG

10-15- 1977 WARD well OLG. Harrison
 date well completed firm name county well located

LANDOWNER: Stuckey Rest.
I-10-MENGIE AVE.
Pass Christian, Miss.

description of formations encountered	from	to
<u>Top Soil</u>	<u>0</u>	<u>18</u>
<u>S.S.</u>	<u>18</u>	<u>35</u>
<u>Red gravel - sd</u>	<u>35</u>	<u>296</u>
<u>Clay - Silt</u>	<u>296</u>	<u>340</u>
<u>sd - clay</u>	<u>340</u>	<u>386</u>
<u>Clay - Silt</u>	<u>386</u>	<u>410</u>
<u>sd</u>	<u>410</u>	<u>478</u>
<u>Clay - Silt</u>	<u>478</u>	<u>515</u>
<u>sd coarse</u>	<u>515</u>	<u>565</u>

WELL LOCATION:
 sec 25 T 7 N R 12 E
8 miles NE of Pass Christian
 (distance) (direction) (nearest town)

WELL PURPOSE: Reservoir
 (home, irrigation, municipal, industrial)

- WELL COMPLETION DATA:
- (1) diameter (inches) 4" x 2"
 - (2) total depth (feet) 565
 - (3) static water level (feet) 60 below top of ground.
 - (4) casing Galv. 249
 (material) (depth)
 - (size) If telescope see back.
 - (5) screen 18 -
 (length) (depth to top)
2" S.S.
 (size) (material)
 - (6) pump 1 1/2 35
 (HP) (yield gpm)
Elec.
 (type power)
 - (7) electric log NO
 (yes or no)
N/A
 (organization running log)
 - (8) how well bottom plugged B.W.U.

CODED


RECEIVED
 NOV - 2 1977
 MISS. BB. OF WATER COMM.

DRILLERS REMARKS:

If well telescopes please sketch and show depths.

GROUND LEVEL

2 1/2" casing →
← 210' - 4" casing →
← 2" casing →

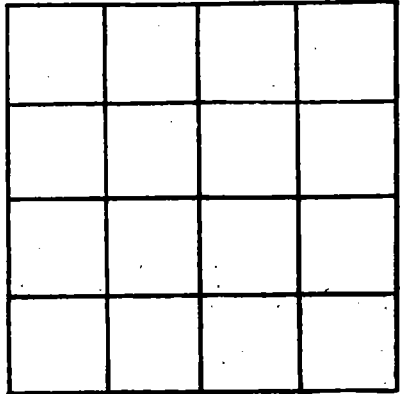

SECTION 25

Please indicate well location X.

ADDITIONAL INFORMATION

Had extreme layers of gravel around 1200 ft. depth.
Installed 1 1/2 H.P. Submersible Pump - 1 1/2" discharge at 126 feet in well.

If more than one screen, show locations of each on sketch.