

HARRISON
K205
1/13/78

MISSISSIPPI
BOARD OF WATER COMMISSIONERS
416 North State Street
Jackson, Mississippi 39201

CODED

WATER WELL DRILLERS LOG

Jan. 13 1978 *Kuncan Well Drilling* *Harrison*
date well completed firm name county well located

LANDOWNER: *Leroy Massey*
Box 6250 Rt. 1
Sheppard
(mailing address)

description of formations encountered	from	to
<i>Red Clay</i>	<i>0</i>	<i>20</i>
<i>Blue clay</i>	<i>20</i>	<i>282</i>
<i>fine sand</i>	<i>280</i>	<i>290</i>
<i>Blue clay</i>	<i>290</i>	<i>485</i>
<i>fine sand</i>	<i>485</i>	<i>510</i>
<i>Course sand</i>	<i>510</i>	<i>546</i>

WELL LOCATION:
sec. *34* T. *7* N. R. *12* E
4 miles *S* of *Long Beach*
(distance) (direction) (nearest town)

WELL PURPOSE: *Home*
(home, irrigation, municipal, industrial)

WELL COMPLETION DATA:

(1) diameter (inches) *2"*

(2) total depth (feet) *546*

(3) static water level (feet) *8'* ^{below} _{above} top of ground.

(4) casing *2" PVC* *546*
(material) (depth)

— If telescope see back.
(size)

(5) screen *10'* *536*
(length) (depth to top)

2" *PVC* *50-40*
(size) (material)

(6) pump *1* *12*
(HP) (yield gpm)

electric
(type power)

(7) electric log *—*
(yes or no)

—
(organization running log)

(8) how well bottom plugged *Sand*
Sharp

CODED


RECEIVED
JAN 25 1978

DRILLERS REMARKS:

MISS. BD. OF WATER COMMISSIONERS

If well telescopes please sketch and show depths.

GROUND LEVEL

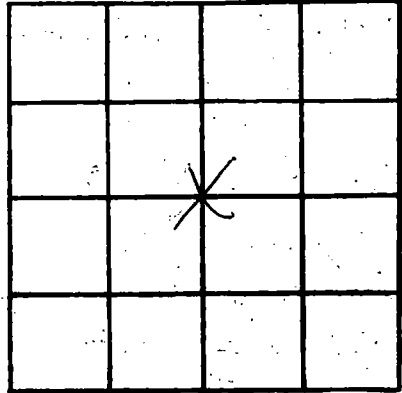

SECTION 34

Please indicate well location X.

ADDITIONAL INFORMATION

If more than one screen, show locations of each on sketch.