

HARRISON
K213
8/17/78
8/17/78

MISSISSIPPI
 BOARD OF WATER COMMISSIONERS
 416 North State Street
 Jackson, Mississippi 39201

CODED

WATER WELL DRILLERS LOG

date well completed 19 Coastal Drilling firm name Harrison county well located
Bilal Miss

LANDOWNER: Fernst
Allen
Long Beach, Miss
 (mailing address)

WELL LOCATION:
 sec. 35 T. 7 N. R. 12 E.
Long Beach, Miss
 (distance) (direction) (nearest town)

WELL PURPOSE: home
 (home, irrigation, municipal, industrial)

WELL COMPLETION DATA:
 (1) diameter (inches) 2"
 (2) total depth (feet) 467
 (3) static water level (feet) 10 below above top of ground.
 (4) casing PVC, 457'
 (material) (depth)
 (size) if telescope see back.
 (5) screen 10' 457'
 (length) (depth to top)
2" PVC
 (size) (material)
 (6) pump _____
 (HP) (yield gpm)
 (type power)
 (7) electric log no
 (yes or no)
 (organization running log)

description of formations encountered	from	to
top soil	1	3
Red clay	3	20
White Sand	20	40
Soft Blue Clay	40	210
Sandy Sand	210	240
Soft Blue Clay	240	300
hard blue clay	300	410
fine white sand	410	420
Home water Sand	420	457

CODED

Miss. Board of Water Comm.


APR 6 - 1979

RECEIVED

DRILLERS REMARKS: 2" test work value

If well telescopes please sketch and show depths.

GROUND LEVEL

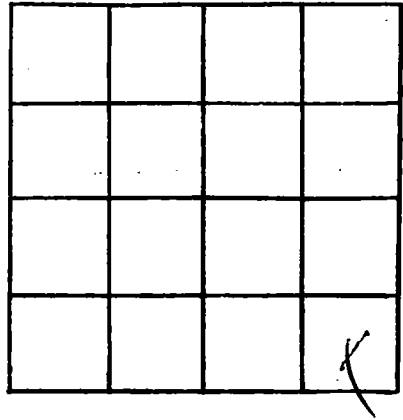

SECTION _____

Please indicate well location X.

ADDITIONAL INFORMATION

If more than one screen, show locations of each on sketch.