

HARRISON  
K217  
3-27-79

MISSISSIPPI  
 BOARD OF WATER COMMISSIONERS  
 416 North State Street  
 Jackson, Mississippi 39201  
 WATER WELL DRILLERS LOG

CODED

3-27 1979 Braden Pump + Well Ser. Inc. HARRISON  
 date well completed firm name county well located

LANDOWNER: Cindy Snyder  
15 Fox Forrest  
Gulfport, MS  
 (mailing address)

WELL LOCATION:  
 sec. 2-T-7 #5 R. 12 #W  
3 miles SW of LYMAN  
 (distance) (direction) (nearest town)

WELL PURPOSE: Home  
 (home, irrigation, municipal, industrial)

- WELL COMPLETION DATA:
- (1) diameter (inches) 4" x 2"
  - (2) total depth (feet) 378 ft
  - (3) static water level (feet) 45 below  
top of ground.
  - (4) casing PVC, 10ft  
(material) (depth)  
4" x 2" if telescope see back.  
(size)
  - (5) screen 10ft, 358  
(length) (depth to top)  
2", PVC over underbar  
(size) (material)
  - (6) pump 1 sub, 20 gal  
(HP) (yield/gpm)  
220V 1φ  
(type power)
  - (7) electric log NO  
(yes or no)  
  
(organization running log)
  - (8) how well bottom plugged  
2" sand shark

description of formations encountered	from	to
Red clay	0	15
White sand	15	20
White clay	20	35
Blue clay	35	50
Sand	50	70
Blue clay	70	115
Sand	115	120
Blue clay	120	150
Brown sand	150	245
Blue clay	245	325
Grey sand	325	343
Blue clay	343	344
Sand	344	368

CODED

Miss. Board of Water Comm.


JUN 14 1979

DRILLERS REMARKS:  
10ft tailpipe below screen

RECEIVED

If well telescopes please sketch and show depths.

GROUND LEVEL

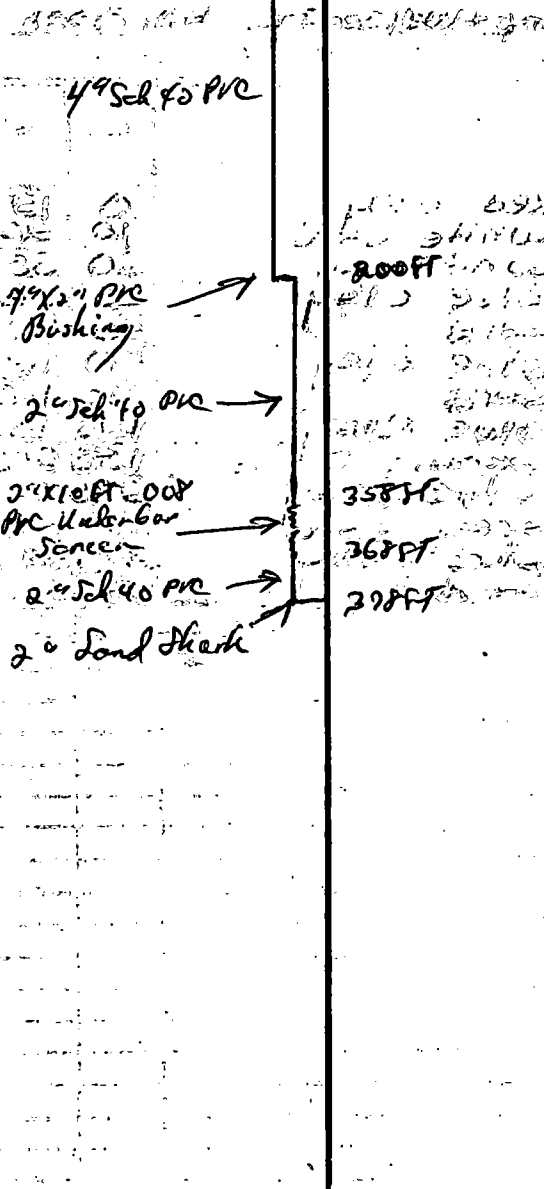

10	10	10	10
10	10	10	10
10	10	10	10
10	10	10	10

SECTION 2

Please indicate well location X.

ADDITIONAL INFORMATION

Blank lines for additional information.

If more than one screen, show locations of each on sketch.

Handwritten notes at the bottom right of the page.