

Check date

HARRISON  
K218  
5-17-76

MISSISSIPPI  
BOARD OF WATER COMMISSIONERS  
416 North State Street  
Jackson, Mississippi 39201

CODED

? WATER WELL DRILLERS LOG

S-17 1976 Braden Pump + well Ser. HARRISON  
date well completed firm name county well located

LANDOWNER: George Brignac  
Ac/Honda Rd (Rt 60) Miss.  
(mailing address)

description of formations encountered	from	to
<u>Yellow clay</u>	<u>0</u>	<u>140</u>
<u>Sand + clay</u>	<u>140</u>	<u>180</u>
<u>Blue clay</u>	<u>180</u>	<u>340</u>
<u>Sand</u>	<u>340</u>	<u>360</u>
<u>Blue clay</u>	<u>360</u>	<u>400</u>
<u>SAND</u>	<u>400</u>	<u>400</u>
<u>BLUE clay</u>	<u>400</u>	<u>500</u>
<u>SAND</u>	<u>500</u>	<u>560</u>
<u>sand + clay</u>	<u>560</u>	<u>+</u>

WELL LOCATION:  
sec. 4 T. 7 N. R. 12 E. S. W  
5 1/2 miles SW of Lyman  
(distance) (direction) (nearest town)

WELL PURPOSE: Home  
(home, irrigation, municipal, industrial)

- WELL COMPLETION DATA:
- (1) diameter (inches) 4 1/2
  - (2) total depth (feet) 560
  - (3) static water level (feet) 28 below above top of ground.
  - (4) casing PVC Total  
(material) (depth)  
4 1/2 if telescope see back.  
(size)
  - (5) screen 10 ft 540  
(length) (depth to top)  
2" PVC Underdrain .008  
(size) (material)
  - (6) pump 1 Subm. 20  
(HP) (yield gpm)  
220 V 1Ø  
(type power)
  - (7) electric log No  
(yes or no)
- (organization running log)
- (8) how well bottom plugged  
2" Sand Shark

CODED



Miss. Board of Water Comm.

JUN 14 1979

DRILLERS REMARKS:  
10 ft. tail pipe  
yellow screen

RECEIVED

If well telescopes please sketch and show depths.

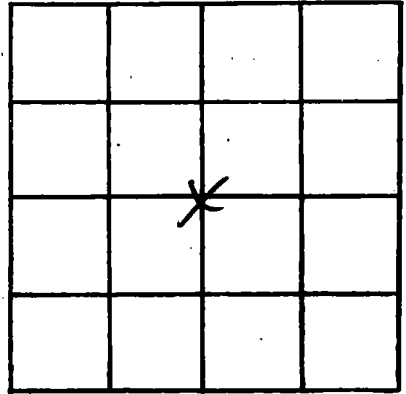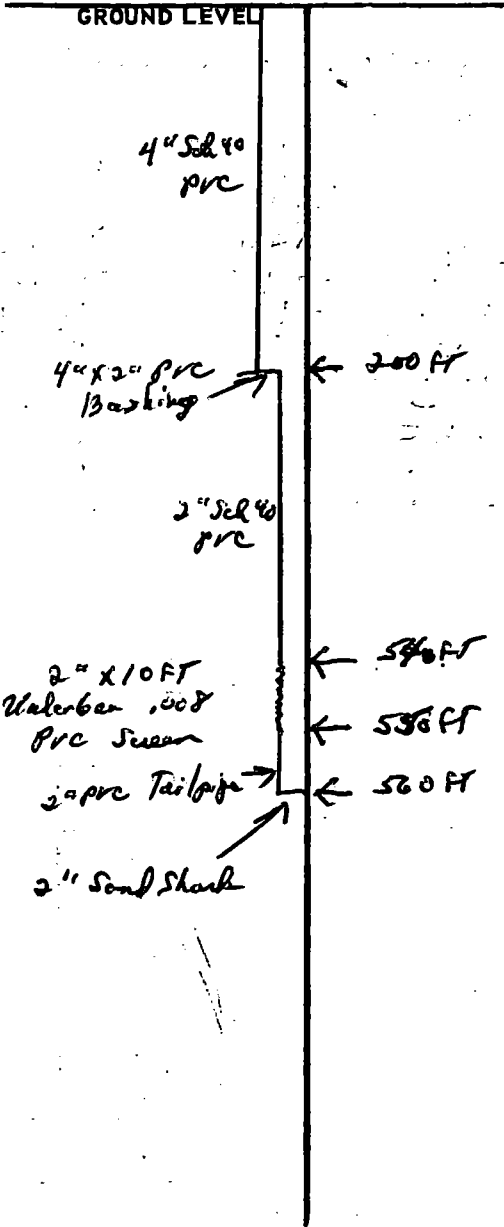

SECTION 4

Please indicate well location X.

ADDITIONAL INFORMATION

Blank horizontal lines for recording additional information.

If more than one screen, show locations of each on sketch.