

HARRISON
K222
04-19-79

MISSISSIPPI
BOARD OF WATER COMMISSIONERS
416 North State Street
Jackson, Mississippi 39201

CODED

WATER WELL DRILLERS LOG

COASTAL DRILLING & SERVICE CO.

04/19/79
date well completed

ROUTE 1 BOX 618

Harrison
county well located

LANDOWNER: Karl Hagen
Esperance
Long Beech, Miss
(mailing address)

MILOXI, MISS. 39532

description of formations encountered	from	to
Top Soil	1	2
Small Red Clay	2	40
White Sand	40	75
Soft Blue Clay	75	210
fine water sand	210	230
Soft Blue Clay	230	310
hard blue clay	310	400
fine water sand (clay)	400	430
hard blue clay	430	580
fine water sand	580	610
Coarse water sand	610	638

WELL LOCATION:

sec. 33 T. 2 N. R. 12 E
S. W.
(2) 1/2 miles North of Long Beech
(distance) (direction) (nearest town)

WELL PURPOSE:

home
(home, irrigation, municipal, industrial)

WELL COMPLETION DATA:

- (1) diameter (inches) 4 1/2
- (2) total depth (feet) 638'
- (3) static water level (feet) 10 below top of ground
- (4) casing PVC 623'
(material) (depth)
4 1/2" If telescope see back.
(size)
- (5) screen 15' 623'
(length) (depth to top)
24 PVC
(size) (material)
- (6) pump one 00
(HP) (yield gpm)
File
(type power)
- (7) electric log no
(yes or no)

(organization running log)

(8) how well bottom plugged
2 backwash valves

DRILLERS REMARKS: 19-B

CODED


DEPT. OF NATURAL RESOURCES
BUREAU OF LAND & WATER RESOURCES

JAN 14 1980

RECEIVED

If well telescopes please sketch and show depths.

GROUND-LEVEL

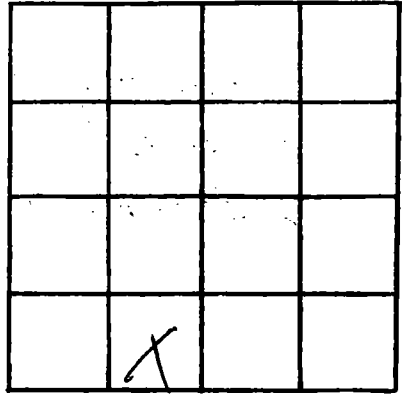

SECTION _____

Please indicate well location X.

ADDITIONAL INFORMATION

160' 4" PVC Casing

458' 2" PVC Casing

20' 2" PVC Screen

2" lock Wash Valve
C/M 19-B

If more than one screen, show locations of each on sketch.