

HARRISON
K224
08-20-79

MISSISSIPPI
BOARD OF WATER COMMISSIONERS
416 North State Street
Jackson, Mississippi 39201

CODED

WATER WELL DRILLERS LOG

Aug. 20 1979 *Duncan Well Drilling Harrison*
date well completed firm name county well located

LANDOWNER: *Glady, Terhead*
Silman Road
Support Mo.
(mailing address)

description of formations encountered	from	to
	<i>Clay</i>	<i>0</i>
<i>Course sand</i>	<i>40</i>	<i>68</i>

WELL LOCATION:
sec *25* T *7* N R *12* E
3 miles *N.W.* of *Support*
(distance) (direction) (nearest town)

WELL PURPOSE: *Home*
(home, irrigation, municipal, industrial)

CODED

WELL COMPLETION DATA:

- (1) diameter (inches) *2"*
- (2) total depth (feet) *68 ft.*
- (3) static water level (feet) *10'* ^{below} _{above} top of ground.
- (4) casing *PVC*, *58'*
(material) (depth)
- if telescope see back.
(size)
- (5) screen *10'*, *58'*
(length) (depth to top)
- 2"*, *PVC*
(size) (material)
- (6) pump *1/2*, *13*
(HP) (yield gpm)
- electric*
(type power)
- (7) electric log _____
(yes or no)

(organization running log)


(8) how well bottom plugged *Good*
Shale

DRILLERS REMARKS:

FEDERAL RESOURCES
STATE OF MISSISSIPPI WATER RESOURCES
JAN 14 1980
RECEIVED

If well telescopes please sketch and show depths.

GROUND LEVEL

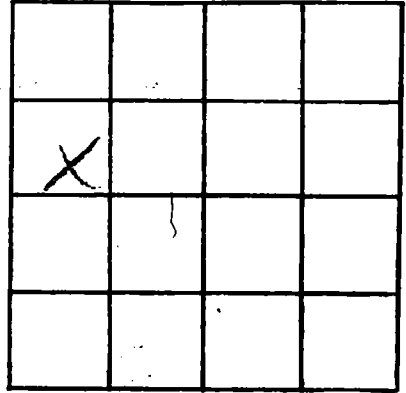

SECTION 25

Please indicate well location X.

ADDITIONAL INFORMATION

If more than one screen, show locations of each on sketch.