

HARRISON
K 228
3-6-80

MISSISSIPPI
BOARD OF WATER COMMISSIONERS
416 North State Street
Jackson, Mississippi 39201

CODED

WATER WELL DRILLERS LOG

March 6 1980 *80 Duncan Well Drilling Harrison*
date well completed firm name county well located

LANDOWNER: *David C. Cather*
Pt. 9, 14 Yorkshire Plany
Huffman, Mo. 37501
(mailing address)

description of formations encountered	from	to
<i>White Clay</i>	<i>0</i>	<i>60</i>
<i>Sand</i>	<i>60</i>	<i>60</i>
<i>Blue Clay</i>	<i>90</i>	<i>320</i>
<i>Fine Sand</i>	<i>320</i>	<i>380</i>
<i>Coarse Sand</i>	<i>380</i>	<i>410</i>

WELL LOCATION:
sec *28* T *7* N R *12* E
5 miles *S.E. of Long Beach*
(distance) (direction) (nearest town)

WELL PURPOSE: *Home*
(Home, Irrigation, municipal, industrial)

CODED

- WELL COMPLETION DATA:
- diameter (inches) *2"*
 - total depth (feet) *410 ft.*
 - static water level (feet) *15'* ^{below} top of ground
 - casing *PVC*, *400'*
(material) (depth)
If telescope see back.
(size)
 - screen *10'*, *400'*
(length) (depth to top)
2" *PVC*
(size) (material)
 - pump *1* *10*
(HP) (yield gpm)
electric
(type power)
 - electric log *---*
(yes or no)
(organization running log)
 - how well bottom plugged *---*
Mark

DEPT. OF NATURAL RESOURCES
BUREAU OF LAND & WATER RESOURCES


MAY 16 1980

RECEIVED

DRILLERS REMARKS:

If well telescopes please sketch and show depths.

GROUND LEVEL

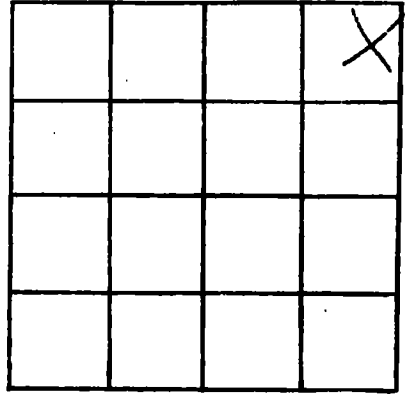

SECTION 28

Please indicate well location X.

ADDITIONAL INFORMATION

If more than one screen, show locations of each on sketch.