

HARRISON
K 232
7-2-80

MISSISSIPPI
BOARD OF WATER COMMISSIONERS
416 North State Street
Jackson, Mississippi 39201

WATER WELL DRILLERS LOG CODED

July 2 1980 *Duncan Well Drilling Harrison*
Date well completed firm name county well located

LANDOWNER: *Jay Deschamp*
Rt. 2 Box 239-B
Bas Christian, Mo.
(mailing address)

description of formations encountered	from	to
Clay	0	45
Sand	45	70
Blue Clay	70	353
fine Sand	353	380
Course Sand	380	399

WELL LOCATION:
sec. 18 T. 7 N. R. 12 E.
8 miles N.W. of Long Beach
(distance) (direction) (nearest town)

WELL PURPOSE: home
(home, irrigation, municipal, industrial)

WELL COMPLETION DATA:

(1) diameter (inches) 2"

(2) total depth (feet) 399 1/4

(3) static water level (feet) 55' below above top of ground.

(4) casing PVC 399
(material) (depth)

— If telescope see back.
(size)

(5) screen 10 389'
(length) (depth to top)

2" PVC
(size) (material)

(6) pump 1 10
(HP) (yield gpm)

electric
(type power)

(7) electric log _____
(yes or no)

(organization running log)

(8) how well bottom plugged hard
shank

CODED

DEPT. OF NATURAL RESOURCES
BUREAU OF LAND & WATER RESOURCES

SEP 22 1980
RECEIVED



DRILLERS REMARKS:

If well telescopes please sketch and show depths.

01000

GROUND LEVEL

Latitude 11.0000

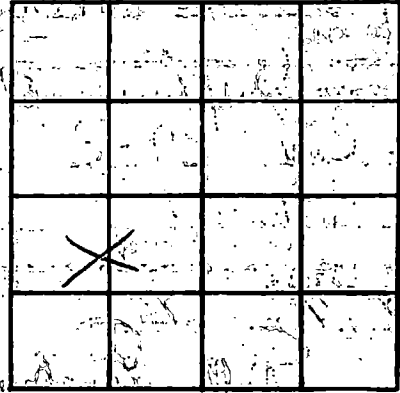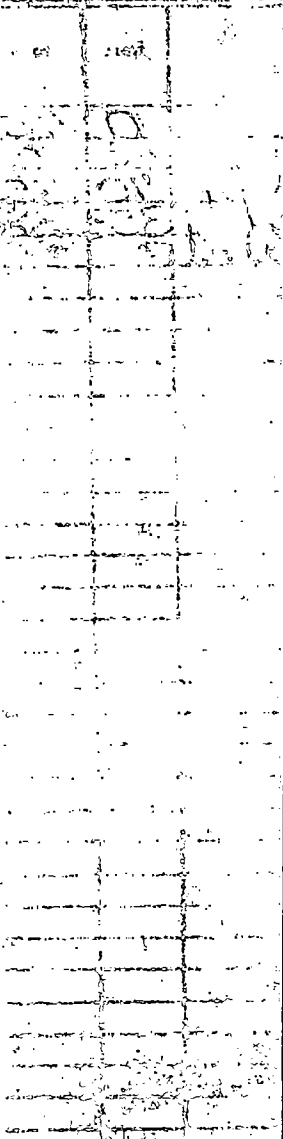

SECTION 18

Please indicate well location X.

ADDITIONAL INFORMATION

A series of horizontal lines for entering additional information, with some faint handwritten notes visible.

If more than one screen, show locations of each on sketch.