

MISSISSIPPI DEPARTMENT OF NATURAL RESOURCES

Bureau of Land and Water Resources

Southport Mall

P.O. Box 10631

Jackson, Mississippi 39209

WATER WELL DRILLERS LOG

HARRISON  
K236  
9-4-80

9-4-1980 date well completed

D. Duncan Well Drilling Harrison firm name

Harrison county well located

LANDOWNER: Don Ulmer  
Rt. 1 Box 625-F  
Ypt. Ms. 39501  
(mailing address)

description of formations encountered

from

to

sand	0	25
clay	25	120
sand	120	140
blue clay	140	460
fine sand	460	530
course sand	530	546

WELL LOCATION:

sec. 34 T 8 N R 12 E  
3 miles N.W of Long Beach  
(distance) (direction) (nearest town)

WELL PURPOSE: Home  
(home, irrigation, municipal, industrial)

WELL COMPLETION DATA:

(1) diameter (inches) 2"  
(2) total depth (feet) 546 ft.  
(3) static water level (feet) 8' below top of ground.  
(4) casing PVC 546'  
(material) (depth)

If telescope see back.  
(size) 10 536'  
(5) screen (length) (depth to top)  
2" PVC  
(size) (material)

(6) pump 1 14  
(HP) (yield gpm)  
electric  
(type power)

(7) electric log                       
(yes or no)

(organization running log)

(8) how well bottom plugged sand  
shack

DRILLERS REMARKS:


DEPT. OF NATURAL RESOURCES  
BUREAU OF LAND & WATER RESOURCES

OCT 31 1980

RECEIVED

If well telescopes please sketch and show depths.

GROUND LEVEL

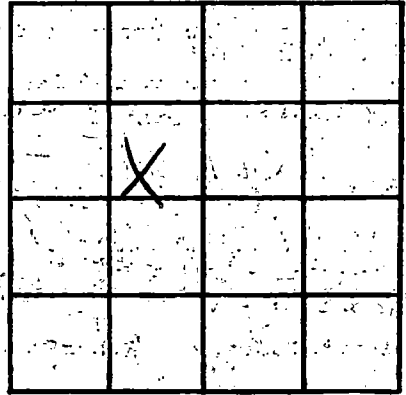

SECTION 34

Please indicate well location X.

ADDITIONAL INFORMATION

If more than one screen, show locations of each on sketch.