

MISSISSIPPI DEPARTMENT OF NATURAL RESOURCES

Bureau of Land and Water Resources

Southport Mall

P.O. Box 10631

Jackson, Mississippi 39209

WATER WELL DRILLERS LOG

HARRISON
K 237
9-12-80

9-12-1980 date well completed
Duncan Well Drilling firm name
Harrison county well located

LANDOWNER: Joan Caillery
Rt. 1 Box 631
Mpt. Ms. 39501
(mailing address)

WELL LOCATION:
sec. 34 T. 81 N. R. 19 E.
3 miles N.W. of Long Beach
(distance) (direction) (nearest town)

WELL PURPOSE: home
(home, irrigation, municipal, industrial)

WELL COMPLETION DATA:
(1) diameter (inches) 2"
(2) total depth (feet) 710 ft.
(3) static water level (feet) 30' below top of ground
(4) casing PVC 710' (material) (depth)
(5) screen 10' 700' (length) (depth to top)
(6) pump 2 PVC (size) (material) 1 (HP) 14 (yield gpm)
electric (type power)
(7) electric log (yes or no)
(organization running log)
(8) how well bottom plugged sand

description of formations encountered	from	to
sand	10	25
white clay	25	120
sand	120	140
blue clay	140	210
fine sand	210	220
blue clay	220	585
fine sand & clay	585	675
fine sand	675	695
course sand	695	710

DEPT. OF NATURAL RESOURCES
BUREAU OF LAND & WATER RESOURCES


OCT 31 1980

RECEIVED

DRILLERS REMARKS:

If well/telescopes please sketch and show depths.

GROUND LEVEL

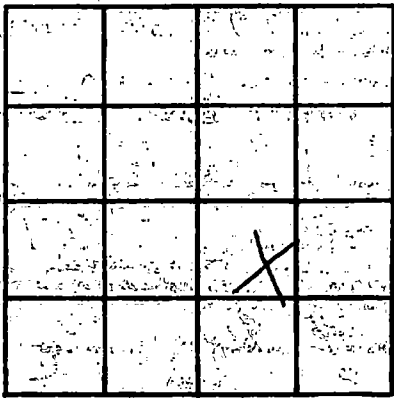

SECTION 34

Please indicate well location X.

ADDITIONAL INFORMATION

If more than one screen, show locations of each on sketch.