

MISSISSIPPI DEPARTMENT OF NATURAL RESOURCES

Bureau of Land and Water Resources

Southport Mall

P.O. Box 10631

Jackson, Mississippi 39209

WATER WELL DRILLERS LOG

COASTAL DRILLING & SERVICE CO.

Harrison
county well located

HARRISON
K 239
6/30/79

6/30/79 19
date well completed

ROUTE 1 BOX 518

BILOXI, MISS. 39532

Ronnie Bouquard
LANDOWNER
Red Cbr Road
pos Christine Man
(mailing address)

description of formations encountered	from	to
<i>Top Soil</i>	<i>1</i>	<i>3</i>
<i>Soft Red clay</i>	<i>3</i>	<i>15</i>
<i>Sandy Sand</i>	<i>15</i>	<i>40</i>
<i>Soft Blue Clay</i>	<i>40</i>	<i>90</i>
<i>Hard Blue Clay</i>	<i>90</i>	<i>230</i>
<i>Sandy Sand</i>	<i>230</i>	<i>240</i>
<i>Hard Blue Clay</i>	<i>240</i>	<i>370</i>
<i>fine water Sand</i>	<i>370</i>	<i>370</i>
<i>good water Sand</i>	<i>370</i>	<i>395</i>

WELL LOCATION:

sec. 33 T 2 N R 12 E
S W
Wolf River
(distance) (direction) of (nearest town)

WELL PURPOSE: *home*
(home, irrigation, municipal, industrial)

WELL COMPLETION DATA:

- (1) diameter (inches) 2"
- (2) total depth (feet) 395'
- (3) static water level (feet) 0 below above top of ground.
- (4) casing PVC 395'
(material) (depth)
- (size) if telescope see back.
- (5) screen 10' 395'
(length) (depth to top)
- 2"
(size) PVC
(material)
- (6) pump one 20
(HP) (yield gpm)
- Ele
(type power)
- (7) electric log no
(yes or no)

(organization running log)

(8) how well bottom plugged
2" hard wood stake

DRILLERS REMARKS: 19-B


DEPT. OF NATURAL RESOURCES
BUREAU OF LAND & WATER RESOURCES

OCT 31 1980

RECEIVED

If well telescopes please sketch and show depths.

GROUND LEVEL

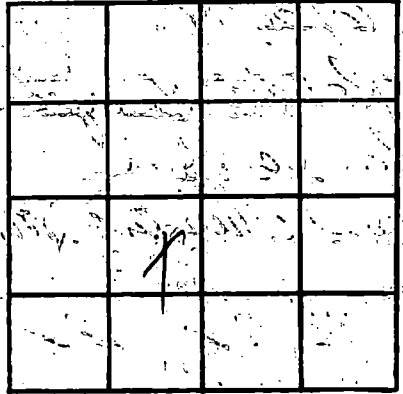

SECTION _____

Please indicate well location X.

ADDITIONAL INFORMATION

If more than one screen,
show locations of each on sketch.