

MISSISSIPPI DEPARTMENT OF NATURAL RESOURCES

Bureau of Land and Water Resources

Southport Mall

P.O. Box 10631

Jackson, Mississippi 39209

WATER WELL DRILLERS LOG

HARRISON
K243
2/4/81

2-4-81 1981 WARD WELL DRILLING HARRISON
date well completed firm name county well located

LANDOWNER: EUGENE LASSABE
RT. 1, Box 823
GULFPORT, MS.
(mailing address)
WELL LOCATION: 12W
sec. 33 T. 7 N. R. 13 E
12 miles N/E of QUEVAS
(distance) (direction) (nearest town)

description of formations encountered	from	to
top soil - clay	0	21
sd	21	32
clay	32	106
sd	106	121
clay - silt	121	380
fine sd	380	402
clay - silt	402	420
coarse sd	420	441

WELL PURPOSE: Home
(home, irrigation, municipal, industrial)


WELL COMPLETION DATA:
(1) diameter (inches) 2"
(2) total depth (feet) 441
(3) static water level (feet) 20 below above top of ground.
(4) casing PVC 421
(material) (depth)
2" if telescope see back.
(size)
(5) screen 10' -
(length) (depth to top)
2" PVC
(size) (material)
(6) pump owner
(HP) (yield gpm)
(type power)
(7) electric log N/A
(yes or no)
N/A
(organization running log)
(8) how well bottom plugged BWW

DRILLERS REMARKS: N/A

DEPT. OF NATURAL RESOURCES
BUREAU OF LAND & WATER RESOURCES
FEB 19 1981
RECEIVED

If well telescopes please sketch and show depths.

GROUND LEVEL

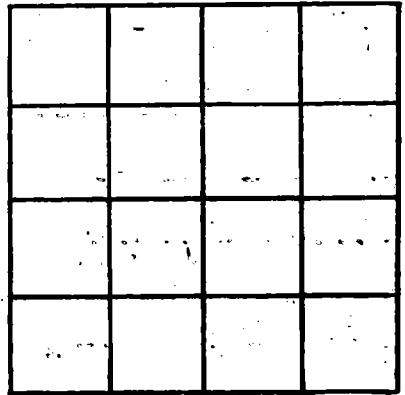

SECTION 23

Please indicate well location X.

ADDITIONAL INFORMATION

If more than one screen,
show locations of each on sketch.