

MISSISSIPPI DEPARTMENT OF NATURAL RESOURCES

Bureau of Land and Water Resources

Southport Mall

P.O. Box 10631

Jackson, Mississippi 39209

WATER WELL DRILLERS LOG

HARRISON  
K244  
11/20/80

11/20/80  
date well completed

Lyman Well Co  
firm name

Harrison  
county well located

LANDOWNER

International Paper Co. - County Farm

description of formations encountered

from

to

Rd - Gpt, Ark  
(mailing address)

yellow clay	0	12
red white clay	12	30
grey clay	30	140
yellow sand	140	200

WELL LOCATION:

sec. 9 T. 7 N. R. 2 E  
10 miles N of Long Beach  
(distance) (direction) (nearest town)

WELL PURPOSE:

(home, irrigation, municipal, Industrial)

WELL COMPLETION DATA:

- (1) diameter (inches) 2"
- (2) total depth (feet) 202'
- (3) static water level (feet) 56 below top of ground
- (4) casing PVC 192' (material) (depth)  
2" (size) if telescope see back.
- (5) screen 10' 192' (length) (depth to top)  
2" (size) PVC (material)
- (6) pump 1 (HP) 12 (yield gpm)  
electric (type power)
- (7) electric log (yes or no)

(organization running log)

(8) how well bottom plugged sand shark

DRILLERS REMARKS:


DEPT. OF NATURAL RESOURCES  
BUREAU OF LAND & WATER RESOURCES

FEB 19 1981

RECEIVED

If well telescopes please sketch and show depths.

GROUND LEVEL

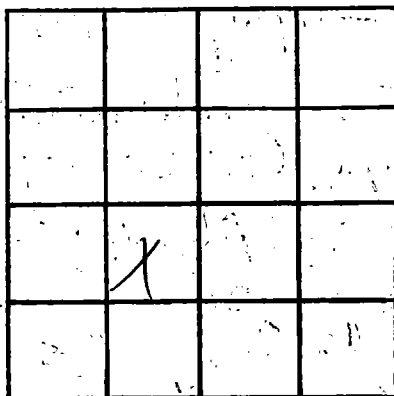

SECTION 9

Please indicate well location X.

ADDITIONAL INFORMATION

If more than one screen,  
show locations of each on sketch.