

MISSISSIPPI DEPARTMENT OF NATURAL RESOURCES

Bureau of Land and Water Resources

Southport Mall

P.O. Box 10631

Jackson, Mississippi 39209

WATER WELL DRILLERS LOG

HARRISON
K245
11/24/80

11-24-80 date well completed

Duncan Well Drilling firm name

Harrison county well located

LANDOWNER: Alton Selkwood

Description of formations encountered

from to

Pt. 2 Box 28

Southport, Ms.
(mailing address)

Clay	0	30
Sand	30	80
White clay	80	160
Blue clay	160	327
Fine sand	327	350
Blue clay	350	460
Fine sand	460	490
Course sand	490	504

WELL LOCATION:

sec 36 T 7 N R 12 E
15 miles (distance) of Lang Road (direction) of (nearest town)

WELL PURPOSE: Home
(home, irrigation, municipal, industrial)

WELL COMPLETION DATA:

- (1) diameter (inches) 2"
- (2) total depth (feet) 504'
- (3) static water level (feet) 60' below top of ground
- (4) casing PVC, 49.4' (material) (depth)
- (5) screen 10' 494' (length) (depth to top)
- 24" PVC (size) (material)
- (6) pump 1 (HP) 12 (yield gpm)
- electric (type power)
- (7) electric log (yes or no)

(organization running log)

(8) how well bottom plugged Sand

DRILLERS REMARKS:


DEPT. OF NATURAL RESOURCES
BUREAU OF LAND & WATER RESOURCES

MAR 18 1981

RECEIVED

If well telescopes please sketch and show depths.

GROUND LEVEL

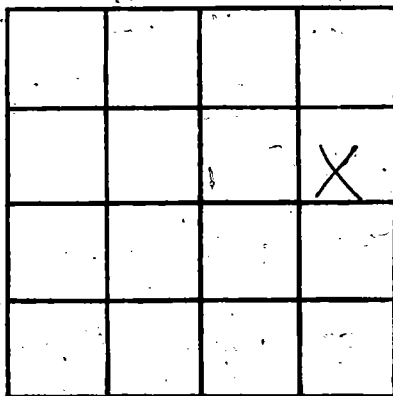

SECTION 36

Please indicate well location X.

ADDITIONAL INFORMATION

If more than one screen, show locations of each on sketch.