

MISSISSIPPI DEPARTMENT OF NATURAL RESOURCES

Bureau of Land and Water Resources

Southport Mall

P.O. Box 10631

Jackson, Mississippi 39209

WATER WELL DRILLERS LOG

HARRISON
K248
3/20/81
3/20/81

date well completed

firm name

county well located

Lyman Well Co.

Harrison

LANDOWNER:

Clyde Wagner

description of formations encountered

from

to

| | | |
|------------------|-----|-----|
| yellow clay | 0 | 11 |
| grey clay | 11 | 20 |
| 2 shades of clay | 20 | 95 |
| blue clay | 95 | 250 |
| sand & silt | 250 | 275 |

(mailing address)

WELL LOCATION:

sec. 4 T 7 N R 12 E
10 miles (distance) W of Long Beach (nearest town)


WELL PURPOSE:

(home, irrigation, municipal, industrial)

Home

WELL COMPLETION DATA:

- (1) diameter (inches) 2"
- (2) total depth (feet) 275'
- (3) static water level (feet) 38' below top of ground
- (4) casing PVC (material), 265' (depth), 2" (size) if telescope see back.
- (5) screen 10' (length), 265' (depth to top), 2" (size), PVC (material)
- (6) pump 1 (HP), 12 (yield gpm), elec (type power)
- (7) electric log No (yes or no), No (organization running log)
- (8) how well bottom plugged sand shark

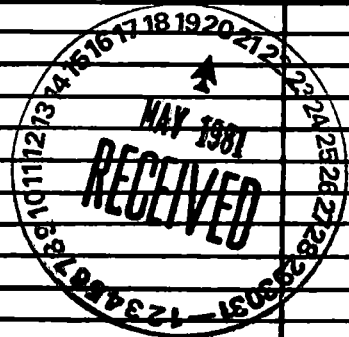

DEPT. OF NATURAL RESOURCES
BUREAU OF LAND & WATER RESOURCES


MAY 20 1981

RECEIVED

DRILLERS REMARKS:

If well telescopes please sketch and show depths.

GROUND LEVEL

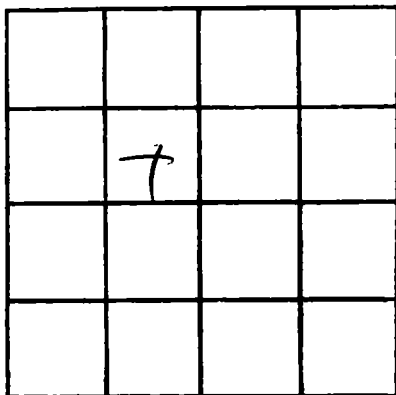

SECTION _____

Please indicate well location X.

ADDITIONAL INFORMATION

Lined area for additional information.

If more than one screen, show locations of each on sketch.