

MISSISSIPPI DEPARTMENT OF NATURAL RESOURCES

Bureau of Land and Water Resources

Southport Mall

P.O. Box 10631

Jackson, Mississippi 39209

WATER WELL DRILLERS LOG

HARRISON  
K249  
3/13/81

date well completed

firm name

county well located

Lyman Well Co.

Harrison

LANDOWNER:

Ralph Del Papa

description of formations encountered

from

to

Rt 11 Box 399  
Gulfport, MS 39503  
(mailing address)

yellow Clay  
Sand & Gravel  
Blue Clay  
yellow Sand.

0 9  
9' 18'  
18' 144  
144 194

WELL LOCATION:


sec. 7 T. 7 N. R. 10 E.  
8 miles (distance) of Gulfport (nearest town)  
(direction)

WELL PURPOSE:

None  
(home, irrigation, municipal, industrial)

WELL COMPLETION DATA:

- (1) diameter (inches) 2"
- (2) total depth (feet) 194'
- (3) static water level (feet) 30' below above top of ground.
- (4) casing PVC (material), 194' (depth), 2" (size) if telescope see back.
- (5) screen 10' (length), 184' (depth to top), 2" (size), PVC (material)
- (6) pump 1 (HP), 15 (yield gpm), electric (type power)
- (7) electric log No (yes or no), No (organization running log)

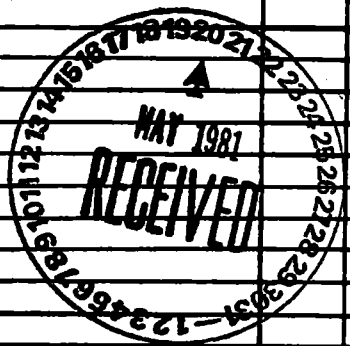

DEPT. OF NATURAL RESOURCES  
BUREAU OF LAND & WATER RESOURCES

MAY 20 1981

**RECEIVED**

DRILLERS REMARKS:

(8) how well bottom plugged sand  
shark


If well telescopes please sketch and show depths.

GROUND LEVEL


SECTION \_\_\_\_\_

Please indicate well location X.

ADDITIONAL INFORMATION

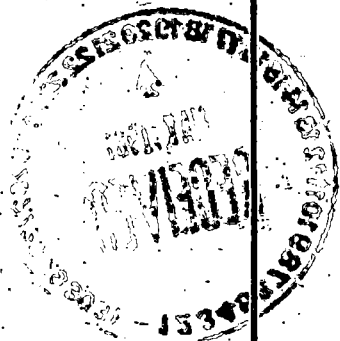

If more than one screen, show locations of each on sketch.