

MISSISSIPPI DEPARTMENT OF NATURAL RESOURCES

Bureau of Land and Water Resources

Southport Mall

P.O. Box 10631

Jackson, Mississippi 39209

WATER WELL DRILLERS LOG

HARRISON
K251
4/28/81
4/28/81

date well completed

19 Lyman Well Co.

firm name

Harrison

county well located

LANDOWNER: AC McClendon

P.O. Box 880
Gulfport, MS 39501
(mailing address)

description of formations encountered

from to

White Sand	0	5
Gray Clay	5	64
Yellow Sand	64	120

WELL LOCATION:


sec 32 T 7 N R 12 E
S W Long Beach
5 miles (distance) W (direction) of (nearest town)

WELL PURPOSE:

(home, irrigation, municipal, industrial) Home

WELL COMPLETION DATA:


- (1) diameter (inches) 2"
- (2) total depth (feet) 120'
- (3) static water level (feet) +4 below top of ground.
- (4) casing PVC (material), 110' (depth), 2" (size) if telescope see back.
- (5) screen 10' (length), 110' (depth to top), 2" (size), PVC (material)
- (6) pump 1/2 SW (HP), 15 (yield gpm), electric (type power)
- (7) electric log No (yes or no), No (organization running log)
- (8) how well bottom plugged sand shark

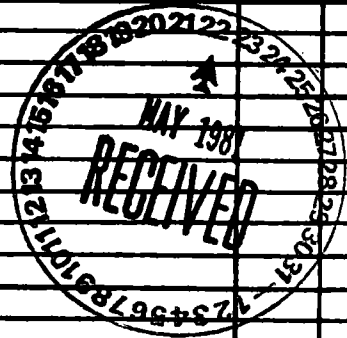

DRILLERS REMARKS:

If well telescopes please sketch and show depths.

GROUND LEVEL

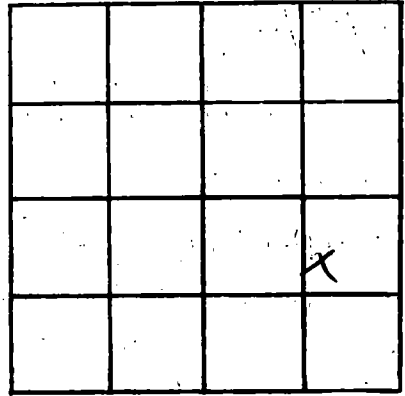

SECTION _____

Please indicate well location X.

ADDITIONAL INFORMATION

If more than one screen, show locations of each on sketch.