

MISSISSIPPI DEPARTMENT OF NATURAL RESOURCES

Bureau of Land and Water Resources

Southport Mall

P.O. Box 10631

Jackson, Mississippi 39209

WATER WELL DRILLERS LOG

HARRISON
K252
4/20/81
4/20/81

date well completed

Lyman Well Co.

firm name

Harrison

county well located

LANDOWNER:

J. J. Reid
Rt 2, Box 65

description of formations encountered

from

to

Pass Christian 39571
(mailing address)

White Sand 0 100
Blue & Gray Clay 100 240

WELL LOCATION:

sec. 7 T. 7 N. R. 12 E.
3 miles (distance) (direction) of Pass Christian (nearest town)

fine sand 240 310

Gray Clay & Shell 310 409

WELL PURPOSE:

(home irrigation, municipal, industrial)

fine sand 409 515

Blue Clay 515 540

WELL COMPLETION DATA:

Good Sand 540 640

(1) diameter (inches) 2 1/2
(2) total depth (feet) 640

(3) static water level (feet) 9 - below top of ground

(4) casing PVC 630' (material) (depth)

2" (size) if telescope see back.

(5) screen 10' 630' (length) (depth to top)

2" (size) PVC (material)

(6) pump 1/2 SW 15 (HP) (yield gpm)


electric (type power)

(7) electric log No (yes or no)

No (organization running log)


(8) how well bottom plugged sand shark

DRILLERS REMARKS: Well Test 10% Mud

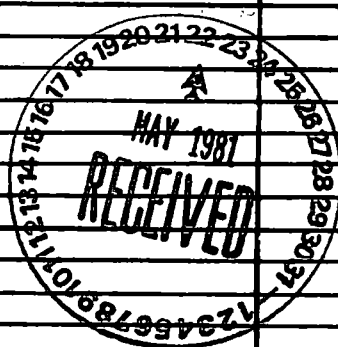

If well telescopes please sketch and show depths.

GROUND LEVEL

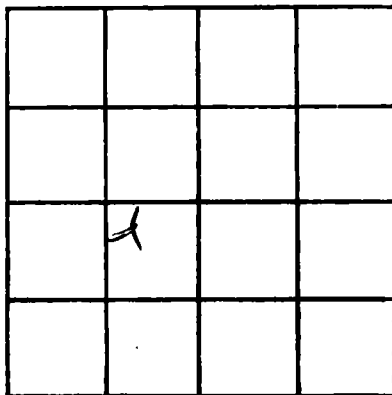

SECTION _____

Please Indicate well location X.

ADDITIONAL INFORMATION

If more than one screen, show locations of each on sketch.