

HARRISON  
K253

MISSISSIPPI  
BOARD OF WATER COMMISSIONERS  
416 North State Street  
Jackson, Mississippi 39201

WATER WELL DRILLERS LOG

4/24/81


4-24-81 19 date well completed

R. T. Mooker firm name

HARRISON county well located

LANDOWNER: Geo B. Mooker  
CHNAK RD.  
Coutspartms  
(mailing address)

description of formations encountered	depth	
	from	to
TOP SOIL	0	10
Red + white clay	10	40
white clay	40	120
Blue clay	120	480
FINE SAND	480	500
MEDIUM Blue Sand	520	520

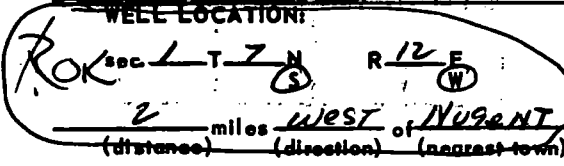

WELL PURPOSE: Home  
(home, irrigation, municipal, industrial)

- WELL COMPLETION DATA:
- (1) diameter (inches) 2'
  - (2) total depth (feet) 520'
  - (3) static water level (feet) 75' below top of ground
  - (4) casing PUC, 510'  
(material) (depth)  
(size) If telescope see back.
  - (5) screen 10', 510'  
(length) (depth to top)  
2, PUC  
(size) (material)
  - (6) pump 1, 8  
(HP) (yield gpm)  
E  
(type power)
  - (7) electric log \_\_\_\_\_  
(yes or no)  
(organization running log)
  - (8) how well bottom plugged 13.12. 26 hrs

DRILLERS REMARKS:

DEPT. OF NATURAL RESOURCES  
BUREAU OF LAND & WATER RESOURCES

MAY 19 1981  
RECEIVED

