

MISSISSIPPI DEPARTMENT OF NATURAL RESOURCES

Bureau of Land and Water Resources

Southport Mall

P.O. Box 10631

Jackson, Mississippi 39209

WATER WELL DRILLERS LOG

HARRISON
K254
3/10/81

March 10, 1981
date well completed

Duncan Well Drilling
firm name

Harrison
county well located

LANDOWNER: Robert Watkins

description of formations encountered

from

to

P.O. Box 3661

Southport, Mo.
(mailing address)

Clay	0	10
Sand	10	30
White Clay	50	115
Blue Clay	115	225
fine sand	225	250
course sand	250	273

WELL LOCATION:

sec. 33 T. 7 N. R. 12 E.
8 miles NW of Lyons
(distance) (direction) (nearest town)

WELL PURPOSE: Home
(home, irrigation, municipal, industrial)

WELL COMPLETION DATA:

- (1) diameter (inches) 2"
- (2) total depth (feet) 273 ft.
- (3) static water level (feet) 30' ^{below} above top of ground.
- (4) casing PVC, 263' (material) (depth)
- (5) screen 10', 263' (length) (depth to top)
2" PVC (size) (material)
- (6) pump (HP) (yield gpm)
electric (type power)
- (7) electric log (yes or no)

(organization running log)

(8) how well bottom plugged sand
mark


DRILLERS REMARKS:

DEPT. OF NATURAL RESOURCES
BUREAU OF LAND & WATER RESOURCES
MAY 18 1981

RECEIVED

If well telescopes please sketch and show depths.

GROUND LEVEL

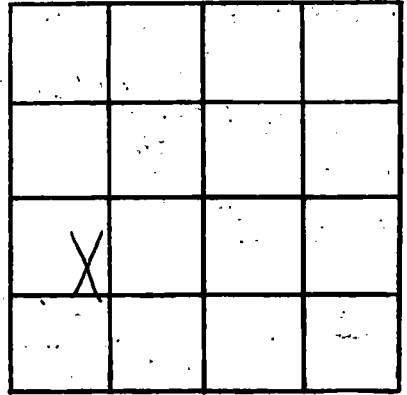

SECTION 33

Please indicate well location X.

ADDITIONAL INFORMATION

If more than one screen, show locations of each on sketch.