

MISSISSIPPI DEPARTMENT OF NATURAL RESOURCES

Bureau of Land and Water Resources

Southport Mall

P.O. Box 10631

Jackson, Mississippi 39209

WATER WELL DRILLERS LOG

HARRISON
K255
3/24/81

March 24 1981
date well completed

81 Duncan Well Drilling
firm name

Harrison
county well located

LANDOWNER: Halley
Menge Ave.
Pass Christian, Ms
(mailing address)

description of formations encountered	from	to
<u>Blue Clay</u>	<u>0</u>	<u>85</u>
<u>Blue Clay</u>	<u>85</u>	<u>280</u>
<u>fine sand</u>	<u>280</u>	<u>305</u>
<u>course sand</u>	<u>305</u>	<u>325</u>

WELL LOCATION:
sec 20 T 9 N R 12 E
10 miles N of Pass Christian
(distance) (direction) (nearest town)

WELL PURPOSE: Home
(home, irrigation, municipal, industrial)


- WELL COMPLETION DATA:
- (1) diameter (inches) 2"
 - (2) total depth (feet) 325 ft.
 - (3) static water level (feet) 60' below top of ground.
 - (4) casing pvc 315'
(material) (depth)
 - (5) screen 10' 315'
(length) (depth to top)
 - (6) pump 1 9
(HP) (yield gpm)
electric
(type power)
 - (7) electric log _____
(yes or no)
 - (8) how well bottom plugged sand
shale

DRILLERS REMARKS:

MISSISSIPPI DEPARTMENT OF NATURAL RESOURCES
BUREAU OF LAND AND WATER RESOURCES
MAY 18 1981
RECEIVED

If well telescopes please sketch and show depths.

GROUND LEVEL

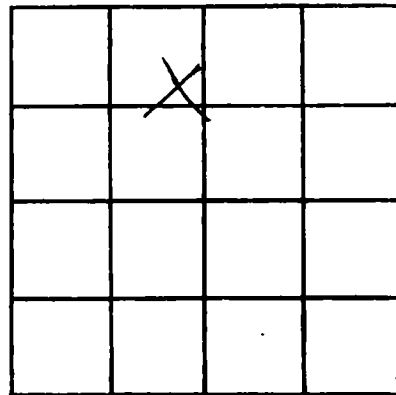

SECTION 20

Please indicate well location X.

ADDITIONAL INFORMATION

If more than one screen, show locations of each on sketch.