

MISSISSIPPI DEPARTMENT OF NATURAL RESOURCES

Bureau of Land and Water Resources

Southport Mall

P.O. Box 10631

Jackson, Mississippi 39209

WATER WELL DRILLERS LOG

HARRISON
K256
3/10/81

March 10 1981 Duncan Well Drilling (Harrison)
date well completed firm name county well located

LANDOWNER: Donald Upbeugh
Rt. 1 Landow Rd.
Lpt. Ms
(mailing address)

description of formations encountered	from	to
<u>Clay</u>	<u>0</u>	<u>15</u>
<u>Fine Sand</u>	<u>15</u>	<u>60</u>
<u>Blue Clay</u>	<u>60</u>	<u>203</u>
<u>Fine Sand</u>	<u>203</u>	<u>235</u>
<u>Course Sand</u>	<u>235</u>	<u>250</u>

WELL LOCATION:
sec. 14 T. 7 N. R. 12 E.
5 miles NW of Southport
(distance) (direction) (nearest town)

WELL PURPOSE: Home
(home, irrigation, municipal, industrial)

WELL COMPLETION DATA:


(1) diameter (inches) 2"
(2) total depth (feet) 250 ft.
(3) static water level (feet) 33' slow above top of ground.
(4) casing PVC 240'
(material) (depth)
10' 240'
(size) If telescope see back. (length) (depth to top)
(5) screen 2" PVC
(size) (material)
(6) pump _____ (HP) _____ (yield gpm)
(type power) _____
(7) electric log _____ (yes or no)
(organization running log) _____
(8) how well bottom plugged Sand

DRILLERS REMARKS: Owner
Had his own
pump

MISSISSIPPI DEPARTMENT OF NATURAL RESOURCES
BUREAU OF LAND & WATER RESOURCES
RECEIVED
MAY 18 1981

If well telescopes please sketch and show depths.

GROUND LEVEL

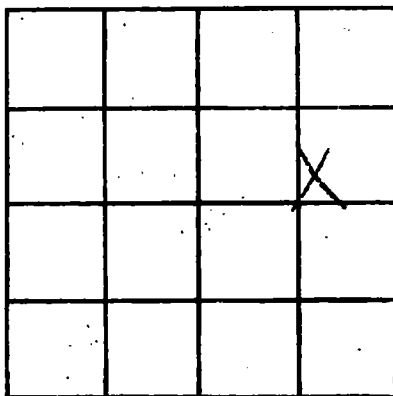

SECTION 14

Please indicate well location X.

ADDITIONAL INFORMATION

If more than one screen, show locations of each on sketch.