

MISSISSIPPI DEPARTMENT OF NATURAL RESOURCES

Bureau of Land and Water Resources

Southport Mall

P.O. Box 10631

Jackson, Mississippi 39209

WATER WELL DRILLERS LOG

HARRISON
K257
1/31/81

Jan. 31 1981 Sumner Well Drilling Harrison county well located

LANDOWNER: Charles Allen
Rt. 1 Box 475 - Allen Rd.
Gpt. Ms.
(mailing address)

description of formations encountered	from	to
<u>Clay</u>	<u>0</u>	<u>45</u>
<u>Fine Sand</u>	<u>45</u>	<u>60</u>
<u>Blue Clay</u>	<u>60</u>	<u>180</u>
<u>Fine Sand</u>	<u>180</u>	<u>198</u>
<u>Coarse Sand</u>	<u>198</u>	<u>210</u>

WELL LOCATION:
sec. 11 T. 7 N. R. 12 E.
7 miles NW of Southport
(distance) (direction) (nearest town)

WELL PURPOSE: Home
(home, irrigation, municipal, industrial)

WELL COMPLETION DATA:

(1) diameter (inches) 2 1/2

(2) total depth (feet) 210 ft.

(3) static water level (feet) 50' below above top of ground.

(4) casing PVC, 200
(material) (depth)

2 1/2 If telescope see back.
(size)

(5) screen 10', 200
(length) (depth to top)

2", PVC
(size) (material)

(6) pump 1, 10
(HP) (yield gpm)

electric
(type power)

(7) electric log
(yes or no)

(organization running log)


(8) how well bottom plugged Sand
Mark

DRILLERS REMARKS:

DEPT. OF NATURAL RESOURCES
BUREAU OF LAND & WATER RESOURCES
MAY 18 1981
RECEIVED

If well telescopes please sketch and show depths.

GROUND LEVEL

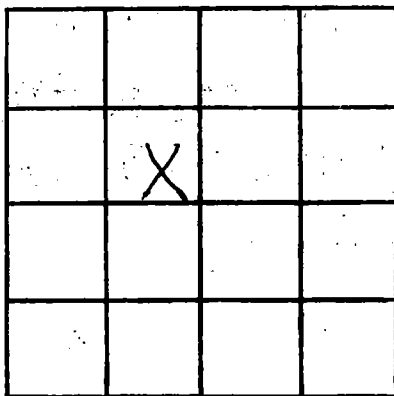

SECTION 11

Please indicate well location X.

ADDITIONAL INFORMATION

If more than one screen, show locations of each on sketch.