

MISSISSIPPI DEPARTMENT OF NATURAL RESOURCES

Bureau of Land and Water Resources

Southport Mall

P.O. Box 10631

Jackson, Mississippi 39209

WATER WELL DRILLERS LOG

COASTAL DRILLING & SERVICE CO.

Route 1 BOX 618

county well located

HARRISON
K 258
1-20-81
1/20/81

date well completed

LANDOWNER

O.B. Woodfill

On Jumbo Rd #5

apt. 201 (mailing address)

WELL LOCATION:

sec. 9 T. 2 N R. 12 E

1/2 miles S of (distance) (direction) of (nearest town)

WELL PURPOSE:

(home, irrigation, municipal, industrial)

WELL COMPLETION DATA:

- (1) diameter (inches) 4 1/2"
- (2) total depth (feet) 570'
- (3) static water level (feet) 60' below top of ground.
- (4) casing PK 555' (material) (depth)
4 1/2" (size) if telescope see back.
- (5) screen 15' 555' (length) (depth to top)
2" (size) PK (material)
- (6) pump 1/2 25 (HP) (yield gpm)
Ele (type power)
- (7) electric log no (yes or no)

(organization running log)

(8) how well bottom plugged

LOXI, MISS. 39532
description of formations encountered

| | from | to |
|-------------------|------|-----|
| top soil | 1 | 3 |
| Red Clay | 3 | 20 |
| Sugar Sand | 20 | 65 |
| Coarse white Sand | 65 | 120 |
| Soft Blue Clay | 120 | 310 |
| Hard Blue Clay | 310 | 490 |
| Light water sand | 490 | 570 |
| Good water sand | 570 | 570 |

DEPT. OF NATURAL RESOURCES
BUREAU OF LAND & WATER RESOURCES

JUN 5 - 1981

DRILLERS REMARKS:

[Handwritten signature]
198

RECEIVED

If well telescopes please sketch and show depths.


GROUND LEVEL

200' 4" PVC Casing

355' 2" PVC Casing

15' 2" PL Screen

2" bed Wash Valve
19 B

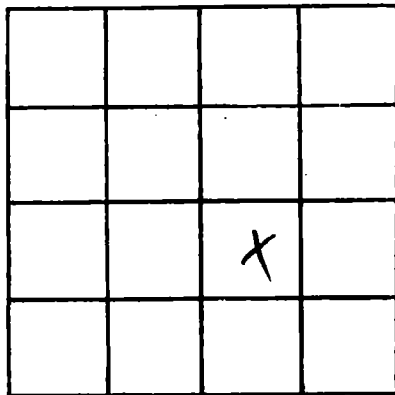

SECTION _____

Please indicate well location X.

ADDITIONAL INFORMATION

If more than one screen, show locations of each on sketch.