

MISSISSIPPI DEPARTMENT OF NATURAL RESOURCES

Bureau of Land and Water Resources

Southport Mall

P.O. Box 10631

Jackson, Mississippi 39209

WATER WELL DRILLERS LOG

HARRISON
K 262
6-16-81

6-16-81 date well completed
Lymas Well Co. firm name
Harrison county well located

LANDOWNER: Wille Mercer
Rt 1 Box 523
Gulfport, Ms 39501
(mailing address)

description of formations encountered	from	to
Sand Red & white	0	40
Gray Clay	40	100
Blue Clay	100	130
Good Sand	130	194

WELL LOCATION:
sec. 33 T. 7 N. R. 12 E
4 miles SW of Oglet
(distance) (direction) (nearest town)

WELL PURPOSE: None
(home, irrigation, municipal, industrial)

- WELL COMPLETION DATA:
- (1) diameter (inches) 2"
 - (2) total depth (feet) 194'
 - (3) static water level (feet) 6' below above top of ground.
 - (4) casing PVC 184'
(material) (depth)
2"
(size) if telescope see back.
 - (5) screen 10' 184'
(length) (depth to top)
2" PVC
(size) (material)
 - (6) pump 1/2 0
(HP) (yield.gpm)
electric
(type power)
 - (7) electric log No
(yes or no)
No
(organization running log)
 - (8) how well bottom plugged Sand
Shark

DRILLERS REMARKS:


DEPT. OF NATURAL RESOURCES
BUREAU OF LAND & WATER RESOURCES

OCT 20 1981

RECEIVED

If well telescopes please sketch and show depths.

GROUND LEVEL

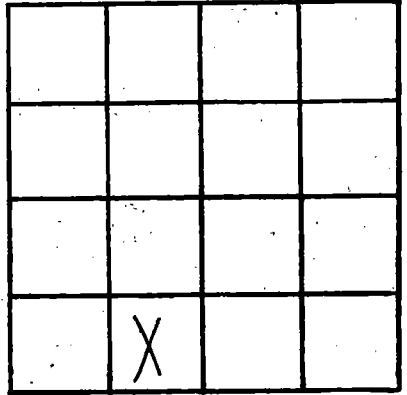

SECTION 35

Please indicate well location X.

ADDITIONAL INFORMATION

If more than one screen, show locations of each on sketch.