

MISSISSIPPI DEPARTMENT OF NATURAL RESOURCES

Bureau of Land and Water Resources

Southport Mall

P.O. Box 10631

Jackson, Mississippi 39209

WATER WELL DRILLERS LOG

20

HARRISON
R 265
4-24-81

April 24 1981 (Luxon Well Drilling Harrison)
date well completed firm name county well located

LANDOWNER: David Elrich
Rt. 1 Box 813
Gulfport, Ms 39501
(mailing address)

description of formations encountered	from	to
Clay	0	100
Sand	100	110
Blue Clay	110	350
Silt Sand	350	430
Course Sand	430	441

WELL LOCATION:
sec. 33 T. 8 N. R. 12 E.
S W
5 miles NW of Long Beach
(distance) (direction) (nearest town)

WELL PURPOSE: home
(home, irrigation, municipal, industrial)

- WELL COMPLETION DATA:
- (1) diameter (inches) 2"
 - (2) total depth (feet) 441 ft.
 - (3) static water level (feet) 20' below top of ground.
 - (4) casing PVC, 431 (material) (depth)
 - (5) screen 10' 431 (length) (depth to top)
2" PVC (size) (material)
 - (6) pump 1 (HP) 14 (yield gpm)
electric (type power)
 - (7) electric log (yes or no)
 - (8) how well bottom plugged Sand
shark


DRILLERS REMARKS:

DEPT. OF NATURAL RESOURCES
BUREAU OF LAND & WATER RESOURCES

OCT 19 1981
RECEIVED

If well telescopes please sketch and show depths.

GROUND LEVEL

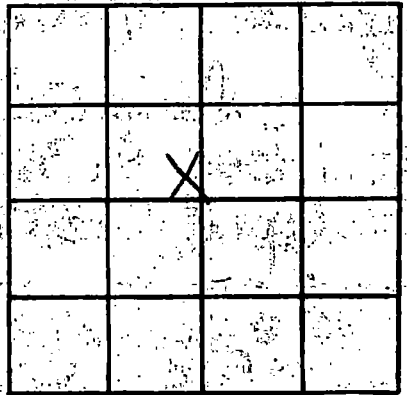

SECTION 33

Please indicate well location X.

ADDITIONAL INFORMATION

If more than one screen, show locations of each on sketch.