

MISSISSIPPI DEPARTMENT OF NATURAL RESOURCES

Bureau of Land and Water Resources

Southport Mall

P.O. Box 10631

Jackson, Mississippi 39209

WATER WELL DRILLERS LOG

Harrison
R 267

July 9 1981
date well completed

81 Duncan Well Drilling
firm name

Harrison
county well located

LANDOWNER: Ruth, Carolini
P.O. Box 3481
Mpt. Mo. 39501
(mailing address)

description of formations encountered	from	to
Clay	0	18
Sand	18	120
Blue Clay	120	420
Fine Sand	420	504
Coarse Sand	504	525

WELL LOCATION:
sec. 31 T 7 N R 12 E
3 miles N.E. of Decatur
(distance) (direction) (nearest town)

WELL PURPOSE: home
(home, irrigation, municipal, industrial)

- WELL COMPLETION DATA:
- diameter (inches) 2'
 - total depth (feet) 525 ft.
 - static water level (feet) 6' below top of ground
 - casing PVC, 515'
(material) (depth)
 - screen 10' 515'
(length) (depth to top)
 - 2" PVC
(size) (material)
 - pump 1 HP 15 yield gpm
(HP) (yield gpm)
 - electric
(type power)
 - electric log (yes or no)

(organization running log)
(8) how well bottom plugged Sand
Shard


DRILLERS REMARKS:

DEPT. OF NATURAL RESOURCES
BUREAU OF LAND & WATER RESOURCES

OCT 19 1981
RECEIVED

If well telescopes please sketch and show depths.

GROUND LEVEL

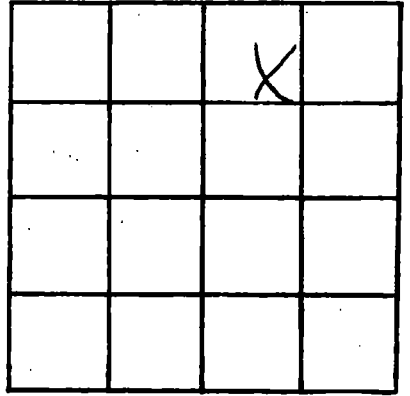

SECTION 37

Please indicate well location X.

ADDITIONAL INFORMATION

If more than one screen, show locations of each on sketch.