

MISSISSIPPI DEPARTMENT OF NATURAL RESOURCES

Bureau of Land and Water Resources

Southport Mall

P.O. Box 10631

Jackson, Mississippi 39209

WATER WELL DRILLERS LOG

HARRISON  
K 270  
8-24-81

Aug. 24 1981 Duncan Well Drilling Harrison  
date well completed firm name county well located

LANDOWNER: Judy East  
147 Markham Dr.  
Long Beach, Ms. 39560  
(mailing address)

WELL LOCATION:  
sec. 34 T 7 N R. 12 E  
3 miles N of Long Beach  
(distance) (direction) (nearest town)

WELL PURPOSE: Home  
(home, irrigation, municipal, industrial)

WELL COMPLETION DATA:  
(1) diameter (inches) 2"  
(2) total depth (feet) 525 ft.  
(3) static water level (feet) 35' below above top of ground.  
(4) casing PVC 515'  
(material) (depth)  
— if telescope see back.  
(size)  
(5) screen 10' 515'  
(length) (depth to top)  
2" PVC  
(size) (material)  
(6) pump 1 12  
(HP) (yield gpm)  
electric  
(type power)  
(7) electric log yes or no  
—  
(organization running log)  
(8) how well bottom plugged Good  
Shark


description of formations encountered	from	to
Clay	0	43
White Clay	43	60
Blue Clay	60	120
White Sand	120	250
Yine Sand	250	290
Blue clay	280	485
Yine Sand	485	504
Charne Sand	504	525

DRILLERS REMARKS: \_\_\_\_\_

DEPT. OF NATURAL RESOURCES  
BUREAU OF LAND & WATER RESOURCES  
OCT 19 1981  
RECEIVED

If well telescopes please sketch and show depths.

GROUND LEVEL

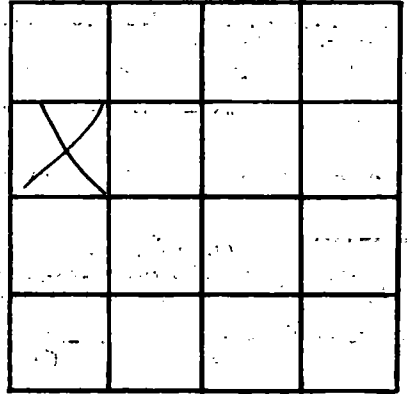

SECTION 34

Please indicate well location X.

ADDITIONAL INFORMATION

If more than one screen, show locations of each on sketch.