

MISSISSIPPI DEPARTMENT OF NATURAL RESOURCES

Bureau of Land and Water Resources

Southport Mall

P.O. Box 10631

Jackson, Mississippi 39209

WATER WELL DRILLERS LOG  
COASTAL DRILLING & SERVICE CO.

ROUTE 1 BOX 618

firm name  
BILOXI, MISS. 39532

county well located

Harrison  
K271

7/2/81  
date well completed

Harrison

LANDOWNER

John Maffrey

description of formations encountered

from to

Rt 5

top soil

1 3

apt Mrs

red clay

3 15

(mailing address)

white clay

15 22

WELL LOCATION:

sec. 4 T. 7 N R. 12 E  
S W  
2 1/2 miles west of (distance) (direction) (nearest town)

course white sand

22 45

3 ft blue clay

45 90

fine water sand

90 170

good water sand

170 185

WELL PURPOSE:

(home, irrigation, municipal, industrial)

WELL COMPLETION DATA:

- (1) diameter (inches) 4"
- (2) total depth (feet) 195'
- (3) static water level (feet) 40' below top of ground.
- (4) casing (material) PVC (depth) 185'
- (size) if telescope see back.
- (5) screen (length) 10' (depth to top) 185'
- (size) 4" (material) PVC
- (6) pump (HP) One 1/2 (yield gpm) 20 gpm
- (type power) ele
- (7) electric log (yes or no) no

(organization running log)

(8) how well bottom plugged  
4" hard disk valve

DRILLERS REMARKS:


DEPT. OF NATURAL RESOURCES  
BUREAU OF LAND & WATER RESOURCES

JAN 15 1982

RECEIVED

If well telescopes please sketch and show depths.

GROUND LEVEL

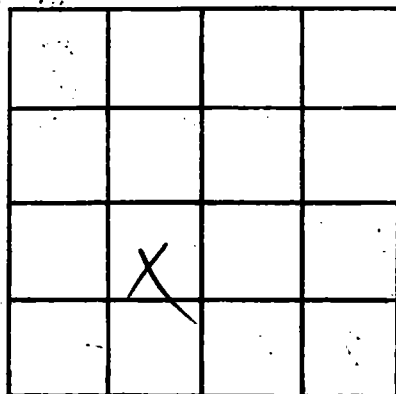

SECTION \_\_\_\_\_

Please indicate well location X.

ADDITIONAL INFORMATION

If more than one screen, show locations of each on sketch.