

MISSISSIPPI DEPARTMENT OF NATURAL RESOURCES

Bureau of Land and Water Resources

Southport Mall

P.O. Box 10631

Jackson, Mississippi 39209

WATER WELL DRILLERS LOG
COASTAL DRILLING & SERVICE CO.

Harrison
K273

8/11/81
date well completed

ROUTE 1 BOX 618
firm name

Harrison
county well located

BILOXI MISS. 39532

LANDOWNER: Will Morgan
Ch. Jam. Road
Hpt, Miss
(mailing address)

description of formations encountered	from	to
Top Soil	1	3
Red Clay	3	25
White Sand	25	60
Soft Blue Clay	60	180
Gray white sand	180	220
Soft Blue Clay	220	340
Hard Blue Clay	340	470
Light water sand	470	510
Heavy gray water sand	510	540

WELL LOCATION:
sec. 5 T. 7 N. R. 12 E.
S. W.
Big Creek
(distance) miles (direction) or (nearest town)

WELL PURPOSE: Home
(home, irrigation, municipal, industrial)

WELL COMPLETION DATA:

(1) diameter (inches) 2"

(2) total depth (feet) 540'

(3) static water level (feet) 90' below above top of ground.

(4) casing PVC, 530'
(material) (depth)
(size) If telescope see back.

(5) screen 10', 530'
(length) (depth to top)
2", PVC
(size) (material)

(6) pump None, 10 gpm
(HP) (yield/gpm)
gle
(type power)

(7) electric log no
(yes or no)
(organization running log)

(8) how well bottom plugged 2" track wash
Water
DRILLERS REMARKS: Sand Seal


DEPT. OF NATURAL RESOURCES
BUREAU OF LAND & WATER RESOURCES

JAN 21 1982

RECEIVED

If well telescopes please sketch and show depths.

GROUND LEVEL

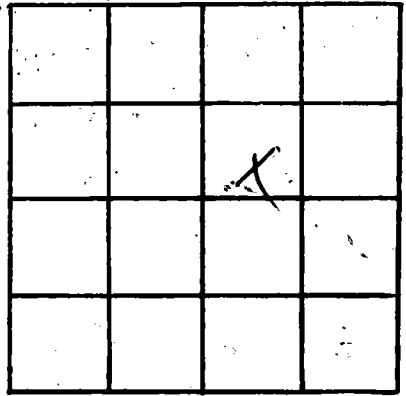

SECTION _____

Please indicate well location X.

ADDITIONAL INFORMATION

If more than one screen, show locations of each on sketch.