

MISSISSIPPI DEPARTMENT OF NATURAL RESOURCES

Bureau of Land and Water Resources

Southport Mall

P.O. Box 10631

Jackson, Mississippi 39209

WATER WELL DRILLERS LOG

Harrison
K275

Nov. 4 1981 Duncan Well Drilling Harrison
date well completed firm name county well located

LANDOWNER: Mr. Sylvan
Marsian Oak Drive
Southport Ms. 39503
(mailing address)

description of formations encountered	from	to
<u>Clay</u>	<u>0</u>	<u>10</u>
<u>Sand</u>	<u>10</u>	<u>50</u>
<u>White clay</u>	<u>50</u>	<u>115</u>
<u>Blue clay</u>	<u>115</u>	<u>225</u>
<u>fine sand</u>	<u>225</u>	<u>250</u>
<u>Coarse sand</u>	<u>250</u>	<u>273</u>

WELL LOCATION:
sec. 33 T 7 N R. 12 E
8 miles NW of Osborne
(distance) (direction) (nearest town)

WELL PURPOSE: Home
(home, irrigation, municipal, industrial)

WELL COMPLETION DATA:

- (1) diameter (Inches) 2"
- (2) total depth (feet) 273ft.
- (3) static water level (feet) 30' ^{below} above top of ground.
- (4) casing PVC, 263'
(material) (depth)
— If telescope see back.
(size)
- (5) screen 10', 263'
(length) (depth to top)
2", PVC
(size) (material)
- (6) pump 1 10
(HP) (yield gpm)
electric
(type power)
- (7) electric log —
(yes or no)
—
(organization running log)
- (8) how well bottom plugged sand
Mark

DRILLERS REMARKS:


DEPT. OF NATURAL RESOURCES
BUREAU OF LAND & WATER RESOURCES

FEB 11 1982

RECEIVED

If well telescopes please sketch and show depths.

GROUND LEVEL

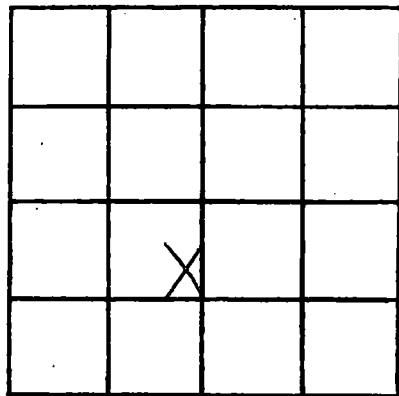

SECTION 33

Please indicate well location X.

ADDITIONAL INFORMATION

If more than one screen, show locations of each on sketch.