

MISSISSIPPI DEPARTMENT OF NATURAL RESOURCES

Bureau of Land and Water Resources

Southport Mall

P.O. Box 10631

Jackson, Mississippi 39209

WATER WELL DRILLERS LOG  
COASTAL DRILLING & SERVICE CO.

Harrison  
K276

11/19/81  
date well completed

ROUTE 1 BOX 618

firm name

Harrison  
county well located

BILOXI, MISS. 39532

LANDOWNER: Don Rogers

description of formations encountered

from

to

Beef Cicle (P 285)

Top Soil

1 3

apt min  
(mailing address)

Red Clay

3 15

Super Sand

15 60

Soft Blue Clay

60 160

Super Sand

160 185

Soft Blue Clay

185 270

High Blue Clay

270 390

fine water sand

390 410

good water sand

410 435

WELL LOCATION:

sec. 35 T 7 N R 12 E

Inset E of W  
(distance) (direction) (nearest town)

WELL PURPOSE:

(home, irrigation, municipal, industrial) home

WELL COMPLETION DATA:

- (1) diameter (inches) 2'
- (2) total depth (feet) 435'
- (3) static water level (feet) 20' below top of ground
- (4) casing PVC 435'  
(material) (depth)
- (size) if telescope see back.
- (5) screen 10' 425'  
(length) (depth to top)
- 2" PVC  
(size) (material)
- (6) pump Uline 15  
(HP) (yield gpm)
- cle  
(type power)
- (7) electric log no  
(yes or no)

(organization running log)

(8) how well bottom plugged

2' back wash valve  
DRILLERS REMARKS: Sub Seal


DEPT. OF NATURAL RESOURCES  
BUREAU OF LAND & WATER RESOURCES

FEB 15 1982

RECEIVED

If well telescopes please sketch and show depths.

GROUND LEVEL

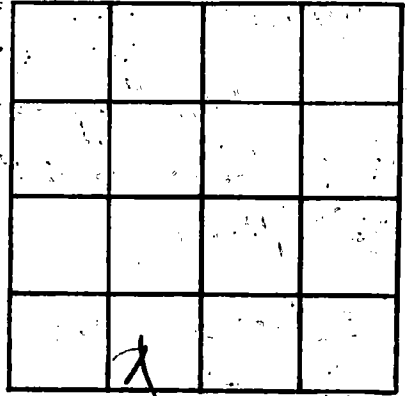

SECTION \_\_\_\_\_

Please indicate well location X.

ADDITIONAL INFORMATION

If more than one screen, show locations of each on sketch.